


GENERAL NOTES

1. REFER TO R-SERIES REFRIGERATION SHEETS.
2. REMOVE AND REINSTALL WIRELESS REFRIGERATION TEMPERATURE SENSORS AS DIRECTED BY KROGER.
3. UPON PROJECT CLOSEOUT, PROVIDE A FRAMED ARCHITECTURAL D-SIZE RECORD DRAWING, SUITABLE FOR WALL MOUNTING, DOCUMENTING THE INSTALLED ROUTING OF CASE CONTROLLER WIRING OVERLAIN ON THE BUILDING PLAN.

SYMBOL	
	REFRIGERATION CIRCUIT DESIGNATION
	DEFROST TERMINATION THERMOSTAT
	ANALOG TEMPERATURE SENSOR
	DOOR SWITCH WIRE WITH 18/4
	PROTOCOL INPUT/OUTPUT BOARDS
	ETHERNET JACK
	SUCTION STOP SOLENOID ^{1,2} MATCH RACK OR DISTRIBUTED UNIT CONTROL VOLTAGE.

1. WHEN CASES ARE FED FROM LOOP PIPING, SUCTION STOP SOLENOIDS WILL BE ON REFRIGERATION CIRCUITS ON SALES FLOOR.
2. REFER TO PIPING DRAWINGS (R3, R4, R5) FOR EXACT LOCATIONS

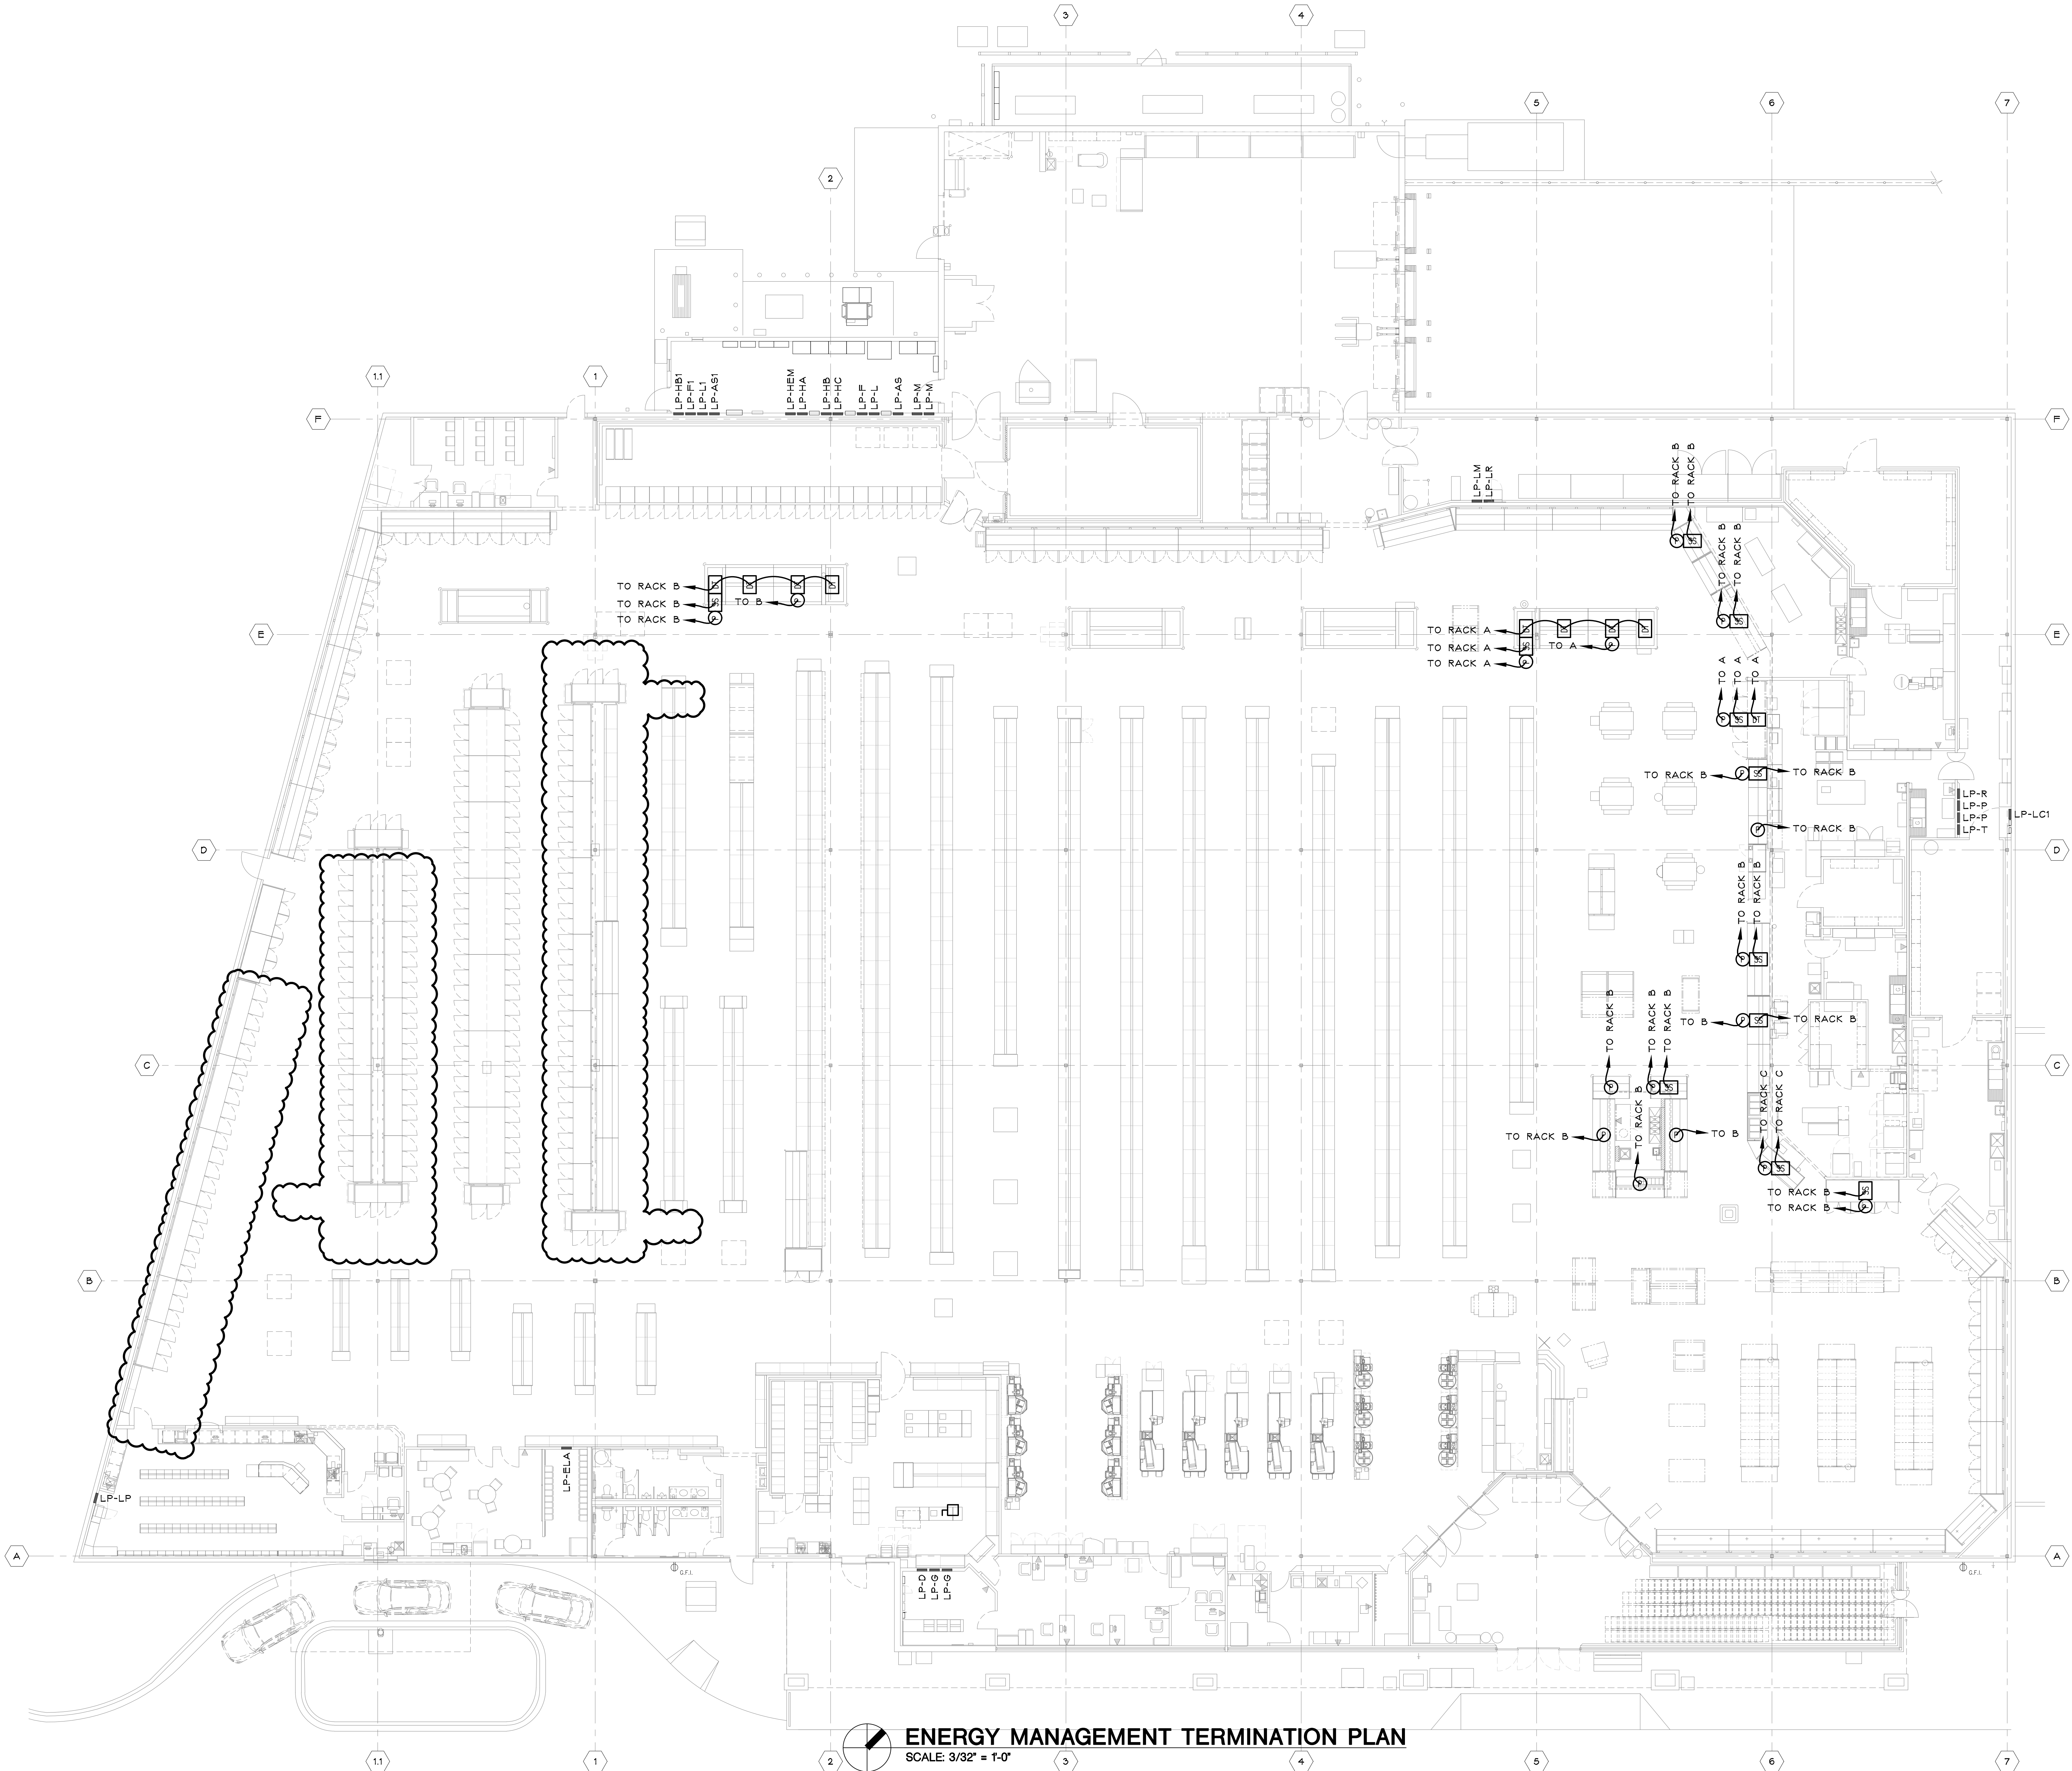

ENERGY MANAGEMENT TERMINATION PLAN

SCALE: 3/32" = 1'-0"

ADDENDUM NO. 1
BIDS AND PERMITS
DIRECT BUY QUOTE
90% OWNER REVIEW

03/18/2024
08/06/2024
02/19/2024
01/25/2024

PROPOSED MINOR INTERIOR
REMODEL FOR:



STORE NO. D-711

7084 MILLER ROAD
SWARTZ CREEK, MI 48473

THE KROGER CO. OF MICHIGAN



32316 grand river ave. suite 200
farmington, michigan 48336-3261
(248) 476-8800 fax (248) 476-8833

ENERGY MGMT TERM PLAN

project no.

23086

sheet no.

EM-2

copyright © 2024