This file was Created on 3/2/2023 @ 4:13:43 PM

ADMINISTRATIVE

1	A10	BANQUET CHAIR
1	ACLRB-T7	TOSHIBA S7 SCO W/ BELTED TAKE AWAY ON RIGHT
1	ACRLB-T7	TOSHIBA S7 SCO W/ BELTED TAKE AWAY ON LEFT
4	ALS9679	ENTERPRISE MARKETPLACE CHECKSTAND (96" FM-79" RM)
2	AUAS	ENTERPRISE SELF-CHECKOUT ATTENDANT STATION
2	E38AS	POS EQUIPMENT FOR SCO ATTENDANT STATION
4	E38SS	SCANNER/SCALE (NO DISPLAY)
5	E38TP	THERMAL PRINTER (FOR CHECKSTANDS)
5	E38TS	TOUCHSCREEN POS (FOR OEM MOUNT)
3	GE107	BIOMETRIC READER FOR T&A
6	GE14	OFFICE CHAIR
6	GE156	EFT PIN PAD & CREDIT CARD READER
2	GE36-5	FILE CABINET (5-DRAWER LATERAL)
5	GE38	POS TERMINAL WITH CASH DRAWER
1	GE67	MONEY ORDER MACHINE (VENDOR SUPPLY)
1	GE68	CALCULATOR
2	GE7	DESK

ARCHIVE

3	ACLR4C-T	TOSHIBA W/ 4 BAG CAROUSEL ON RIGHT (DEACTIVATED)
3	ACRL4C-T	TOSHIBA W/ 4 BAG CAROUSEL ON LEFT (DEACTIVATED)
3	ALU4C	USCAN GENESIS W/ 4 BAG CAROUSEL ON LEFT
3	ARU4C	USCAN GENESIS W/ 4 BAG CAROUSEL ON RIGHT
9	B108R	BAKERY RACK (SINGLE RACK OVEN)
1	B216-5A	5' 2-TIER OPEN AIR ARTISAN BREAD (DEACTIVATED)
1	B216R-5A	5' 1-TIER ROLL FIXTURE (DEACTIVATED)
5	B225E	BAKERY NESTING TABLE SET (DEACTIVATED)
1	B299-4	CAKE MENU BOARD (4 PANEL) (DEACTIVATED)
1	B55S	BREAD SLICER STAND (DEACTIVATED)
1	D171	DOUBLE STACKED ROTISSERIE
6	DA1	ROLL IN RACK FOR MILK - JUICE - CULTURE
1	E22TV-42	LCD WIDESCREEN (42") (DEACTIVATED)
1	E9K	EAS KEYPAD (INFO. PANEL)
2	E9L	EAS PEDESTALS (6' TO 9' OPENING)
9	GE16	FOLDING CHAIR
8	GE1S	SCONCE FLY ZAPPER (AREAS IN CUSTOMER VIEW)
1	GE3	COPY MACHINE
7	GE53	ELECTRIC SERVICE ENTRANCE
4	GE62	REMOVABLE POST & RAILING (CONTRACTOR SUPPLY)
1	GE65	SAFE
14	GE88	LOCKERS (6 TIER/LOUVERED DOORS)
25	GE93	PALLET RACK
1	GM3V	4FT CIGARETTE FIXTURE (DEACTIVATED)
1	GM85BT	BATTERY ENDCAP CHECKSTAND MERCHANDISER
2	GM85BV	BEVERAGE ENDCAP CHECKSTAND MERCHANDISER
1	GM85KF	KPF ENDCAP CHECKSTAND MERCHANDISER
4	GM85LG	LARGE TAIL CHECKSTAND MERCHANDISER
1	HDR	RECESSED HAND DRYER
1	M115	MEAT WRAPPER (TABLE TOP)
1	M54-12	12' MEAT SERVICE CASE HUMIDITY CONTROL/TIMER
1	M56T	EAS LABEL APPLIER (METTLER TOLEDO) (DEACTIVATED)
4	P53	3' X 3' ORCHARD BIN (UPSCALE) (DEACTIVATED)
19	P71B	BULK PRODUCE TABLE (DEACTIVATED)
4	P71HB	HALF SIZE BULK PRODUCE TABLE (DEACTIVATED)
7	P71LE	PRODUCE TABLE LEFT END
7	P71RE	PRODUCE TABLE RIGHT END
10	PLHSP	HAND SINK (PEDESTAL BASE)
1	S115	SEAFOOD WRAPPER (TABLE TOP)
2	ST1-480S	24V CHARGER (480V-1PH-260 AMPS PER HOUR)
5	BV5D12HX	12' FIVE-DECK BEVERAGE CASE
2	BV5D8HX	8' FIVE-DECK BEVERAGE CASE
1	BV5DLSMEHX	FIVE-DECK BEVERAGE LEFT SLAB MIRRORED END
1	BV5DRSMEHX	FIVE-DECK BEVERAGE RIGHT SLAB MIRRORED END
2	D5DL12HX	12' FIVE-DECK DELI CASE W/ LOW FRONT RAIL
2	D5DLLSMEHX	FIVE-DECK DELI CASE LEFT SLAB MIRRORED END
2	D5DLRSMEHX	FIVE-DECK DELI CASE RIGHT SLAB MIRRORED END
2	DA6	6' VERTICAL SHELF DAIRY CASE
4	DAE	VERTICAL SHELF DAIRY CASE END
16	DMD12	12' MULTI-DK DELI CASE
6	DMDE	MULTI-DK DELI CASE END
1	DMDL12HP	12' MDLP DELI CASE (48" H.)
1	DMDL8HP	8' MDLP DELI CASE (48" H.)
1	DMDLLEHP	MDLP CASE LEFT END (48" H.)
1	DMDLREHP	MDLP CASE RIGHT END (48" H.)
1	F5DN12HX	12' 5-DECK NARROW FLORAL CASE
1	F5DNLGEHX	5-DECK NARROW FLORAL CASE LEFT GLASS END
1	F5DNRGEHX	5-DECK NARROW FLORAL CASE RIGHT GLASS END
5	G85BSC	CHECKSTAND REFRIGERATED MERCHANDISER (DEACTIVATED)
18	GDE	GLASS DOOR END PANEL
2	GE216B	UPRIGHT REFRIGERATOR/FREEZER (DEACTIVATED)
3	M5DFR12HP	12' FIVE-DECK FRESH MEAT CASE (DEACTIVATED)
1	M5DFRLSMEHP	LEFT SLAB MIRRORED END (DEACTIVATED)
1	M5DFRRCMEHP	RIGHT CONTOURED MIRRORED END (DEACTIVATED)
1	MGDNLT6	6' GLASS DOOR LOW TEMP NARROW MEAT CASE
2	MMDL12K	12' MDLP MEAT CASE
4	MMDL8K	8' MDLP MEAT CASE
8	MMDLDE	MDLP INSULATED DIVIDER
1	MS12HE	12' SERVICE MEAT CASE
1	MSLEHE	SERVICE MEAT CASE LEFT PANEL END
1	MSREHE	SERVICE MEAT CASE RIGHT PANEL END
1	MWI12K	12' LOW-TEMP WIDE ISLAND MEAT CASE W/END
1	MWI8K	8' LOW-TEMP WIDE ISLAND MEAT CASE W/END
8	PMD12	12' MULTI-DK PRODUCE WALL CASE
4	PMDE	MULTI-DK PRODUCE WALL CASE END
1	PMSC6B	6' MOBILE SELF CONTAINED PRODUCE CASE

BAKERY

1	B108G	GAS SINGLE RACK OVEN
1	B224	MOBILE CAKE KIT CART
2	B230	BAKERY TRASH CART
1	B234	PRIMETIME DONUT RACK
1	B44T	SERVICE SCALE/UPC PRINTER (TOLEDO)
1	B55	BREAD SLICER
1	BBS4CS	4' PACKAGED DONUT/PASTRY SHELVING BAKERY CASE
1	BULECS	BAKERY WALL CASE LEFT END
1	BURECS	BAKERY WALL CASE RIGHT END
2	B1DFZ5HP	5' SINGLE DECK FROZEN BAKERY CASE
1	B1DFZLEHP	SINGLE DECK FROZEN BAKERY CASE LEFT END
1	B1DFZREHP	SINGLE DECK FROZEN BAKERY CASE RIGHT END
2	BGDNIC8HI	8' NARROW GLASS DOOR ICE CREAM TEMP BAKERY (3 DOORS)
1	BGDNLEHI	NARROW GLASS DOOR BAKERY LEFT END PANEL
1	BGDNREHI	NARROW GLASS DOOR BAKERY RIGHT END PANEL

CONSTRUCTION

2	GE187	SET OF DOCK SEALS
2	GE188	GALVANIZED METAL HOOD W/18" PROJECTION
2	GE190	RAPID FORM PIT
2	GE20	MECHANICAL DOCK LEVELER
11	GE52	SUB FEEDER ELECTRIC PANEL (CONTRACTOR SUPPLY)
1	PL24-2	BI-LEVEL DRINKING FOUNTAIN (CONTRACTOR SUPPLY)
1	PLSV	SPRINKLER VALVE & RISER

DELI-CHEESE

2	D143	POT RACK (WALL MOUNT) (60")
4	D23T	SERVICE SCALE/UPC PRINTER (TOLEDO)
1	D254	CHICKEN LANDING TABLE
1	D259B	COMPLETE CHICKEN TENDERS BREADING CART
2	D26	MANUAL SLICER
1	D304DS-2	4' DOUBLE SIDED SNACK DESTINATION DISPLAY
1	D60DE	OPEN DUAL RACK FRYER (208 VOLT) VERSION
1	TMP-391	DIGITAL ORDER SCREEN & THERMAL PRINTER
1	TMP-392	RAD CHARGING STATION
1	D262SC13	13 PAN QUICK CHILLER WITH TOUCHSCREEN
1	DCBSO8AT	8FT SERVICE HOT CHICKEN AND BBQ CASE
1	DMHF4AM	4' MOBILE HOT FOOD
4	D1DSC4HP	4'X4' (SELF-CONT) REFRIGERATED MOBILE MERCHANDISER
1	DS12HE	12' SERVICE DELI CASE
2	DS8HE	8' SERVICE DELI CASE
1	DSLEHE	SERVICE DELI LEFT PANEL END
1	DSREHE	SERVICE DELI RIGHT PANEL END

DOORS

2	DR30L	2'-6" LEFT HINGED DOOR
2	DR30R	2'-6" RIGHT HINGED DOOR
1	DR36CR	36" RIGHT HINGED COOLER DOOR (84"H)
1	DR36R	3'-0" RIGHT HINGED DOOR (DIRECT BUY)
2	DR48CR	48" RIGHT HINGED COOLER DOOR (84"H)
1	DR48CS	STRIP DOOR FOR 48" COOLER DOOR
1	DR48FS	STRIP DOOR FOR 48" FREEZER DOOR (7'H)
1	DR48SD	4' X 7' DOUBLE ACTION SINGLE PLASTIC DOOR
2	DR60CL	60" LEFT HINGED COOLER DOOR (96"H)
2	DR60CR	60" RIGHT HINGED COOLER DOOR (96"H)
5	DR60CS	STRIP DOOR FOR 60" COOLER DOOR
38	DR24	2'-0" FRENCH DOOR (PER QUOTE)

DRUG-GM

1	GM22V	BATTERY ENDCAP (VENDOR SUPPLY)
1	GM23V	PROPANE TANK CAGE (VENDOR SUPPLY)
10	GM25	3' MARKETPLACE SHADOW BOX FOR FROZEN FOOD AREA
1	GM33V	CARD SPINNER RACK
1	GM9-3	3FT GIFT CARD ENDCAP

ELECTRONICS

1	CN3	FAN/COIL AC UNIT FOR ECR ROOM (3 TON)
11	E102	THINCLIENT & MONITOR
1	E15MK	(2) 2-POST RACK/48 PORT PATCH PANEL MDF BASE KIT
1	E15MR	4-POST MDF RACK
1	E15M	2-POST MDF RACK
2	E6	MFP (FAX PRINTER COPIER SCANNER)
1	E8B	BILL COUNTER
1	GE102A	ACCOUNTING CABINET PC MONITOR & THERMAL PRINTER

FLORAL

1	F41	CUSTOM MILLWORK COUNTER (CONTRACTOR SUPPLY)
2	F45-4	3 TIER 1/2 ROUND GRID TOP FLORAL ROUNDER DISPLAY
3	F46	NESTING TABLE SET
1	F50D-12	12' BALLOON DISPLAY FIXTURE
2	F9	HELIUM TANK (VENDOR SUPPLY)

GENERAL

1	FM	FULL LENGTH MIRROR (CONTRACTOR SUPPLY)
4	GE11C	DEPARTMENT HEAD COMPUTER WORKSTATION
1	GE155-K	KEY ME KIOSK
1	GE155	COIN COUNTER (VENDOR SUPPLY)
2	GE186	MICROWAVE
1	GE198	4FT WOOD SLAT BENCH
3	GE205RCP	CANS AND PLASTIC RECYCLE MACHINE (REAR LOAD)
1	GE215L-480	AUTOMATIC BALER LEFT-HAND HINGED (480V)
5	GE235-3	3 LEVER SPRAY DOWN PROPORTIONER (VENDOR SUPPLY)
7	GE236-2C	2 BUTTON PROPORTIONER FOR 3-COMP SINK (VENDOR SUPPLY)
1	GE242	CLEANING CART
1	GE243	HAZMAT CONTAINMENT TOTE
2	GE245	CART SANI-WIPE DISPENSER (KROGER SUPPLY)
2	GE246	BAG RECYCLE BIN (KROGER SUPPLY)
106	GE252-17K	BASCART (17000 CU. IN. CAPACITY)
25	GE252U	URBAN BASCART
3	GE253-2	2' "INVERTED U" BIKE RACK
1	GE2C	INSTANT LOTTERY TICKET VENDING MACHINE
1	GE2	LOTTERY TERMINAL (SERVICE) (VENDOR SUPPLY)
2	GE301	RESTROOM CLEANER
2	GE302	COOLER CASE CLEANER
1	GE3S	SMART SAFE TR-300
3	GE41	CUSTOM MILLWORK COUNTER (CONTRACTOR SUPPLY)
2	GE44A	BABY CHANGING STATION
9	GE63C-24	PROTECTIVE CHROME CORNER GUARD
24	GE63	REMOVABLE PROTECTIVE POST (SALES AREA)
1	GE81	DSD WALL CABINET
5	GE96B	ELECTRONIC SHOPPING CART (REAR DRIVE)
3	HDR2	DYSON HAND DRYER
4	NR	SANITARY NAPKIN DISPOSAL RECEPTACLE
12	PM	MECHANICAL PAPER TOWEL DISPENSER (KROGER SUPPLY)
17	SD	SOAP DISPENSER (KROGER SUPPLY)
6	TP	TOILET PAPER DISPENSER (KROGER SUPPLY)
2	TR	TRASH RECEPTACLE

GROCERY

2	G1-9648	SALES AREA 96" PALLET RACK SECTION (48"D X 72"H)
1	G102D	WATER DISPENSER (VENDOR SUPPLY)
1	G1S	SALES AREA PALLET RACK STARTER END FRAME (48"D X 72"H)
4	G49-4	4' UNIVERSAL END DISPLAY (18"D)
4	G50-3	3' UNIVERSAL END DISPLAY (24"D)
16	G50-4	4' UNIVERSAL END DISPLAY (24"D)
1	G78-1S	SELF-CHECKOUT MERCHANDISER (SNACK)
2	GMKS	TOSHIBA BELTED SCO MERCHANDISER KIT S
1	GMLBSK	TOSHIBA SYSTEM 7 LEFT BELTED SCO SHELVING KIT
1	GMRBSK	TOSHIBA SYSTEM 7 RIGHT BELTED SCO SHELVING KIT
1	G111SCV	FROZEN FOOD SPOT MERCHANDISER (VENDOR SUPPLY)
1	G80SC-60	60 CU. FT. INDOOR ICE MERCHANDISER (S.C.)

MEAT

2	M-3248	32" 4 WAY MERCHANDISER (48"H)
1	M10	MEAT SAW
1	M11T	SERVICE SCALE/UPC PRINTER (TOLEDO)
1	M14	3-ROLL WRAPPER FOR BELT SEALER
3	M46S	MEAT ISLAND SHELVING DISPLAY
3	M46	HALF ROUND WIRE BIN MERCHANDISER
1	MAPPM	AUTOMATED PRODUCTION PLANNING MONITOR KIT
1	MLR-BSALRBT	MEAT BELT SEAL/AUTOLABEL SYSTEM W/ ROTARY BIN
2	M1DSC4HP	4'X4' (SELF-CONT) REFRIGERATED MOBILE MERCHANDISER

PRODUCE

1	P32T	PRODUCE TOP LOADING SCALE WITH 4 QUART BOWL
1	P69	PRODUCE MARKDOWN RACK
3	P72BN	BANANA TABLE
1	P72LBN	BANANA TABLE WITH LEFT END
1	P72RBN	BANANA TABLE WITH RIGHT END
2	P1DSC4HP	4'X4' (SELF-CONT) REFRIGERATED MOBILE MERCHANDISER
1	P1DSC6J	6'X6' TWO TIER REFRIGERATED PROMO CASE (SELF-CONT)
4	PMSC6M-3	6' ULTRA FRESH BERRY CASE (SELF-CONT) 240 V.

SEAFOOD

1	S24T	SERVICE SCALE/UPC PRINTER (TOLEDO)
1	S36TR-12	REMOTE ICE FLAKER W/ CART TRANSPORT SYSTEM (1500 LB.)
1	SGDNLEHI	NARROW GLASS DOOR SEAFOOD LEFT END PANEL
1	SGDNLT10HI	10' NARROW GLASS DOOR LOW TEMP SEAFOOD (4 DOORS)
1	SGDNREHI	NARROW GLASS DOOR SEAFOOD RIGHT END PANEL
1	SS12HC-DSFM	12' OPEN AIR SERVICE SEAFOOD CASE
1	SSLEHC-DSFM	SERVICE SEAFOOD LEFT PANEL END
1	SSREHC-DSFM	SERVICE SEAFOOD RIGHT PANEL END

SINKS

1	PL1M	(CONTRACTOR SUPPLIED) MOP SINK
1	PL1PC-18	1 COMPARTMENT PREP SINK (18' BOWL) (NO DRAINBOARD)
5	PLG	GREASE INTERCEPTOR
1	PLHSW	HAND SINK (WALL MOUNT)

STOCK HANDLING

1	GE211-4K	POWERED STRADDLE STACKER (4000 LB. CAP.) (KE-FRYS)
1	GE212-4K	POWER PALLET JACK (4500 LB)
1	GE31-3S	3' ERECTA SHELV. (24"D) (STARTER)
3	GE31-4S	4' ERECTA SHELV. (24"D) (STARTER)
1	GE31-4	4' ERECTA SHELV. (24"D)
2	GE32-3	3' ERECTA SHELV. (18"D)
11	GE32-4S	4' ERECTA SHELV. (18"D) (STARTER)
4	GE32-4	4' ERECTA SHELV. (18"D)
2	GE32L-3S	3' LOW PROFILE ERECTA SHELVING 18"D (STARTER)
1	GE32L-3	3' LOW PROFILE ERECTA SHELVING 18"D (ADD ON SECTION)
66	GE6-4	4' OVERHEAD GALV. STORAGE SHELVING (18" DEEP)
10	GE93-102	PALLET RACK (102" SECTION) W/ 1 END FRAME
3	GE93S	PALLET RACK STARTER END FRAME
1	ST7	"GO-BACK" CART

TABLE

1	T4SF	4' OPEN TABLE W/UNDERSHELF (FLAT TOP)
3	T6SF	6' OPEN TABLE W/UNDERSHELF (FLAT TOP)
12	T6S	6' OPEN TABLE W/UNDERSHELF
5	T8D	8' ENCLOSED TABLE

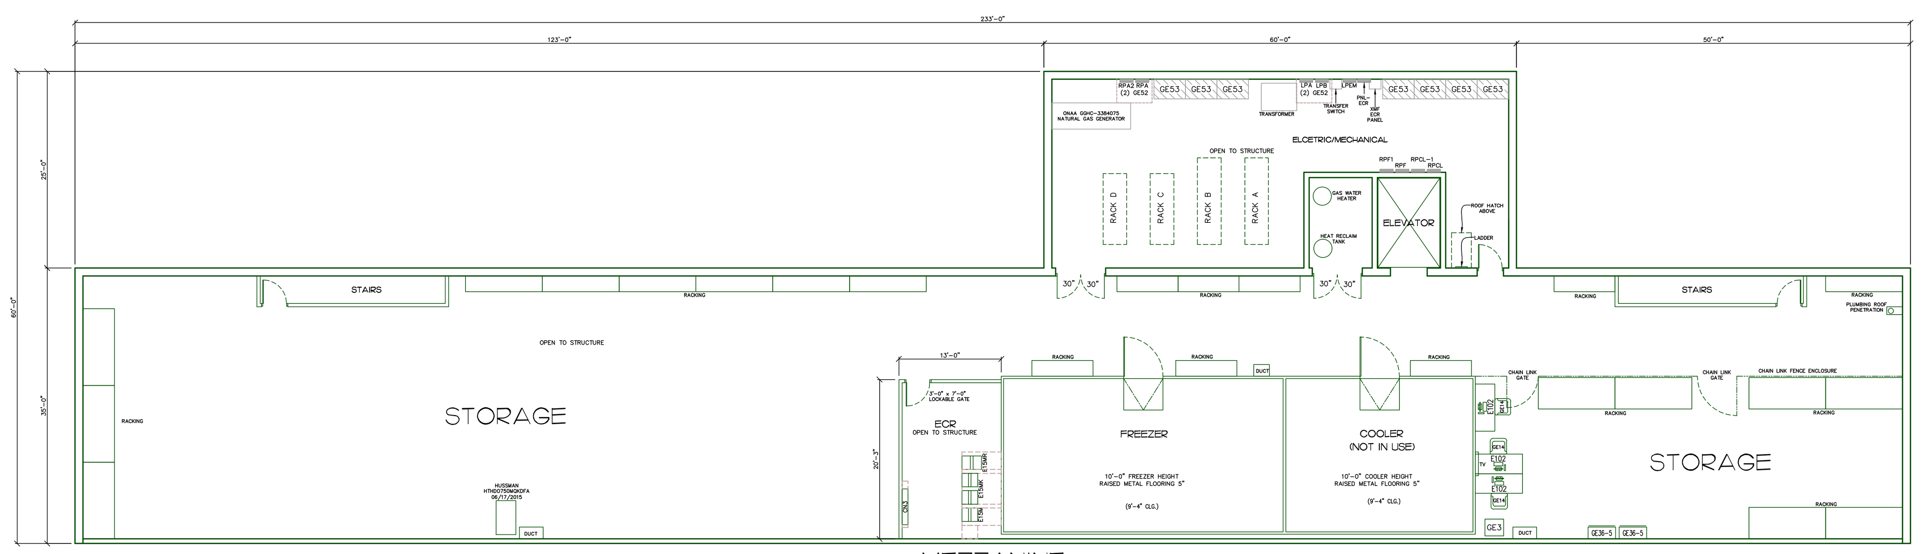

MEZZANINE

233'-0"

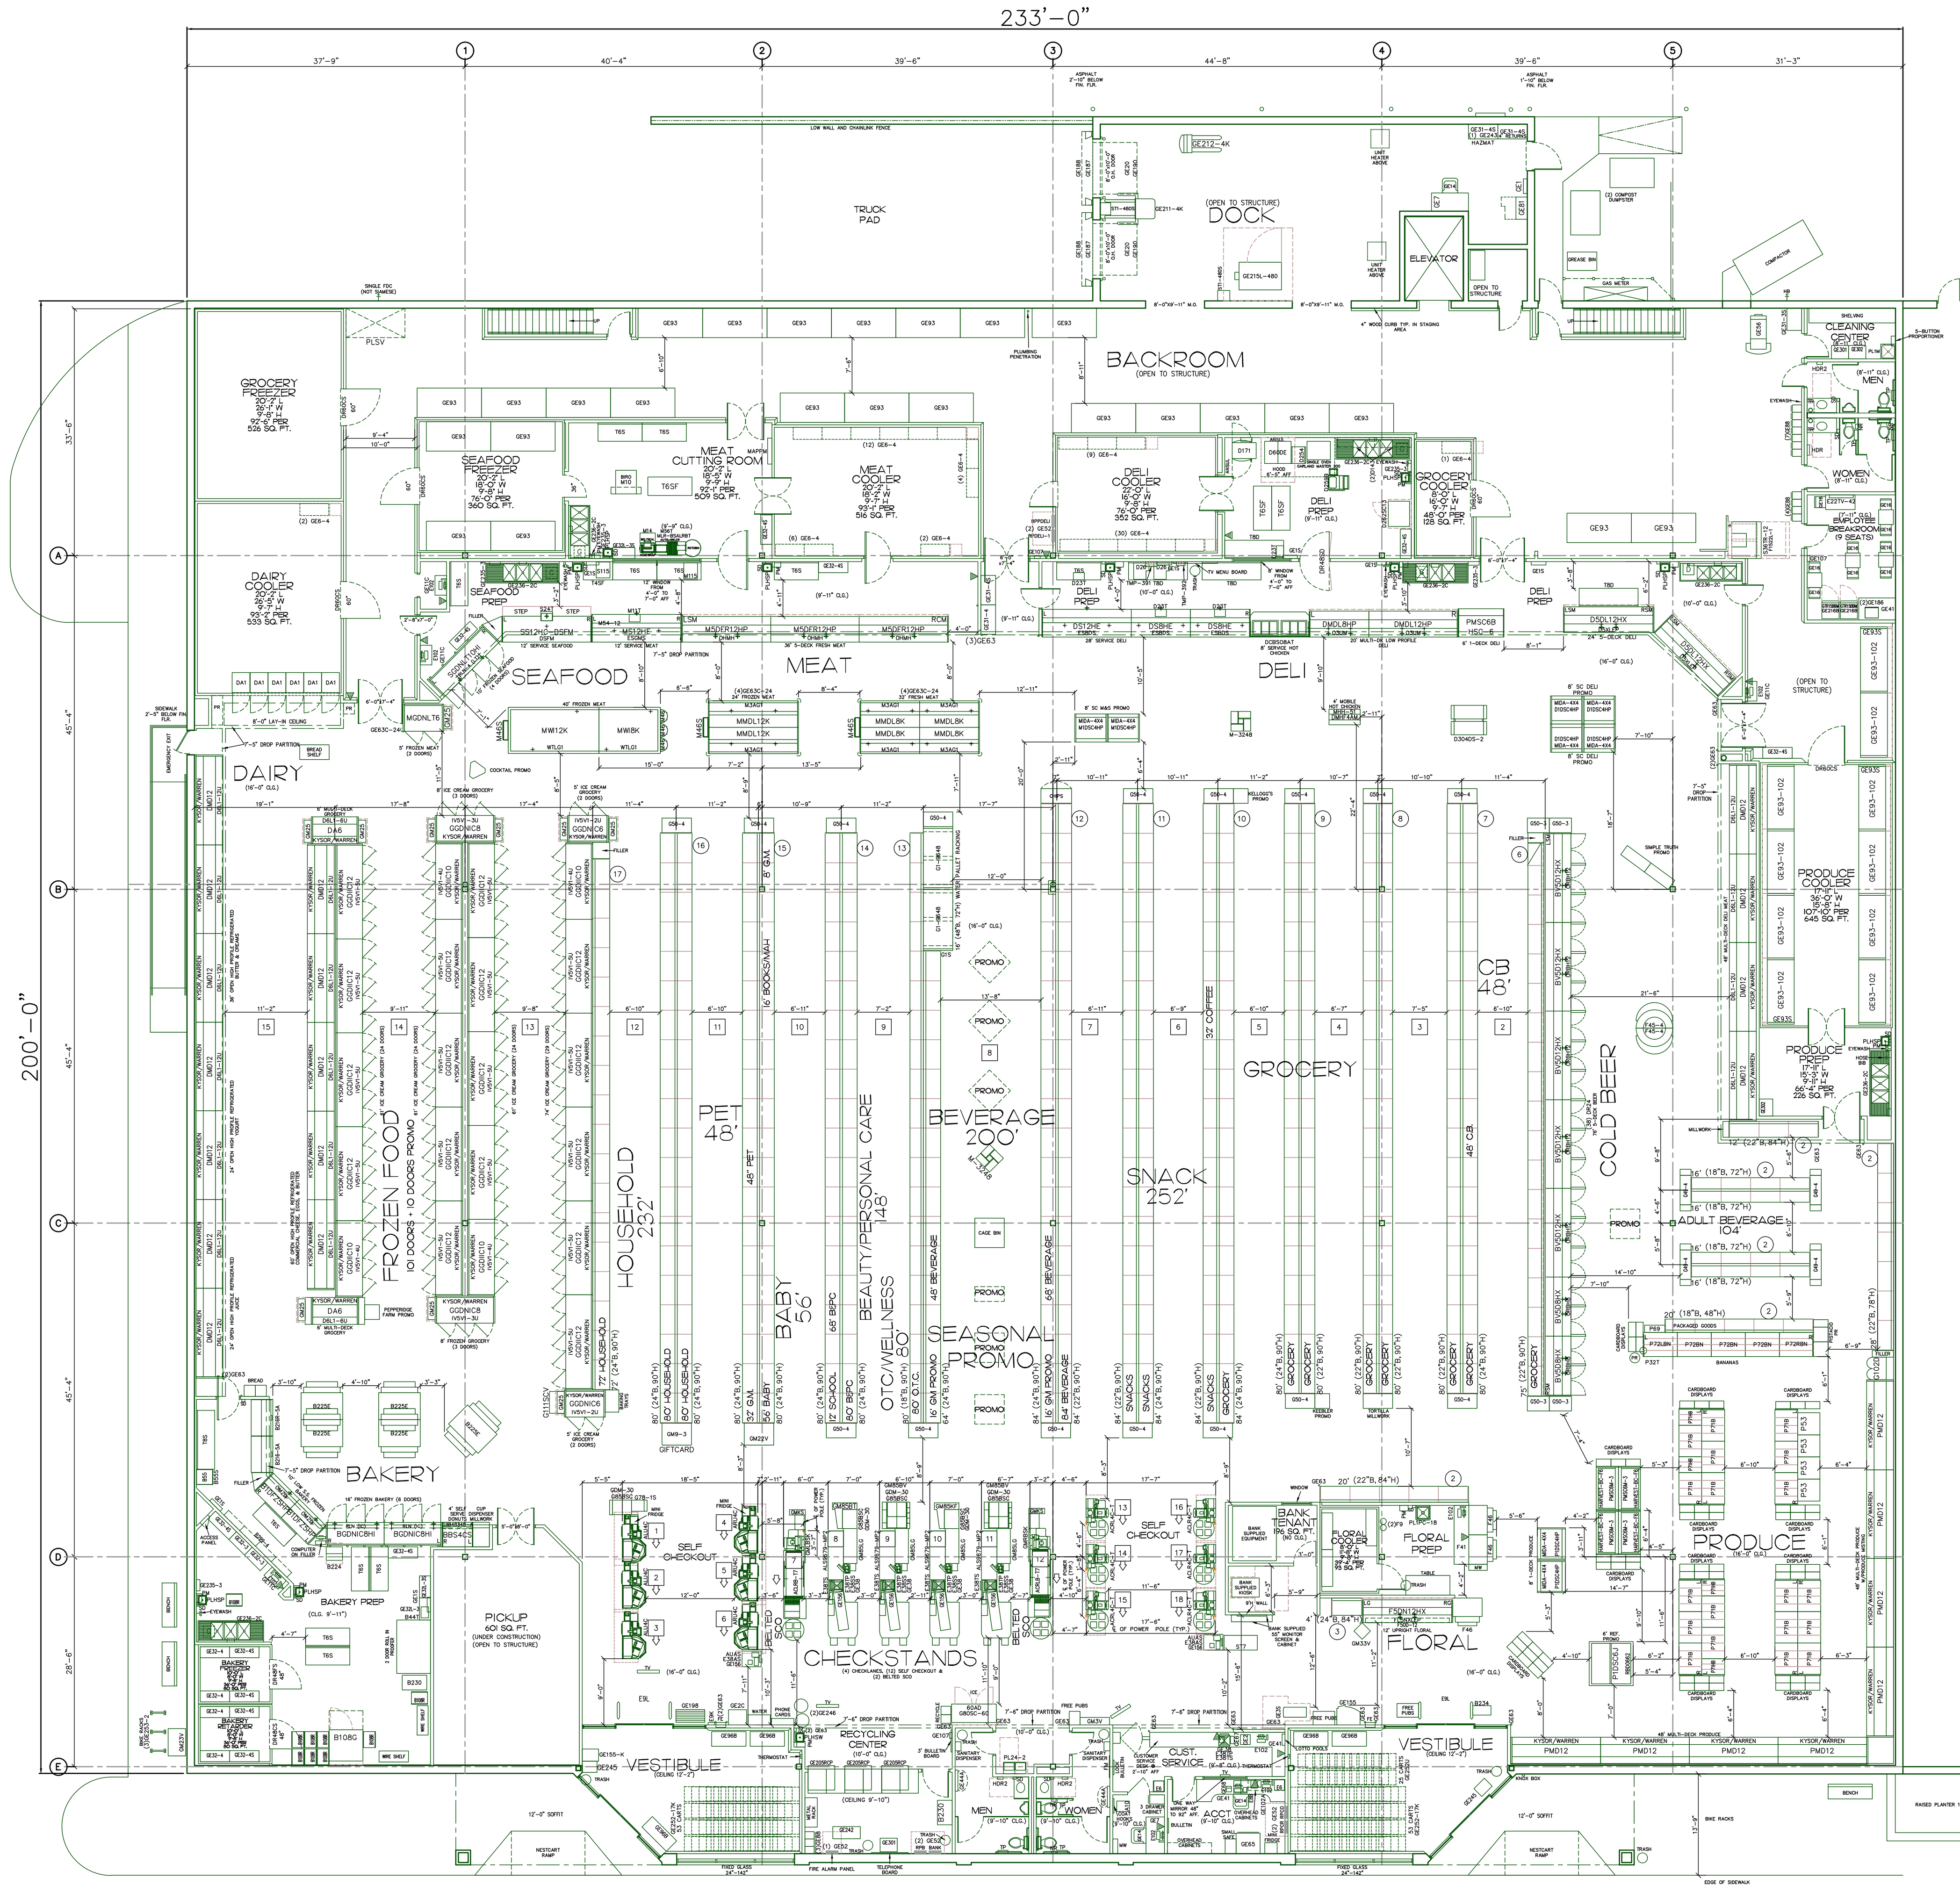

EXISTING PLAN

- FOR REFERENCE ONLY -

NOTE:
THIS DRAWING IS INTENDED ONLY TO SHOW THE REQUIREMENTS OF THE KROGER CO. THE DESIGN OF THE BUILDING TO CONFORM TO ALL APPLICABLE LAWS, CODES, REGULATIONS, ORDINANCES AND APPROVAL OF THE INSPECTION AUTHORITIES HAVING JURISDICTION IS THE RESPONSIBILITY OF THE ARCHITECT EMPLOYED BY THE OWNER.

MICHIGAN
(EXIST) BANNER
40393 GRAND RIVER AVENUE
NOVI, MICHIGAN
PHONE: (248) 957-2254
FAX: (248) 957-2255

Kroger — FRESH FOR EVERYONE™
GENERAL OFFICE
FACILITY ENGINEERING
1014 VINE ST, CINCINNATI, OHIO 45202
PH: (513) 762-1467 FAX: (513) 762-4012

EXISTING
D-365
3615 WASHTENAW AVE
ANN ARBOR, MI 48104

CURRENT PLAN DATE: 3/2/2023
ORIGINAL PLAN DATE: 3/2/2023
DRAWN: D. HOSKINS
CHECKED: NOT CHECKED
REVISIONS:

STANDARD PLOTTED SCALE: 1/16"=1'-0"

BUILDING STATS:

TOTAL SHELVING	1,903 LF
SALES AREA (% OF GROSS BUILDING)	32,568 SF (56 %)
BASE STORE	48,022 SF
MEZZANINE	8,979 SF
DOCK / UTILITY	1,500 SF

GROSS BUILDING 58,500 SF

AS-BUILT FIXTURE PLAN

STEEL PACKAGE ID: Not Applicable

D-365

SHEET: I1.0(XF1)

CAD FILE: