This file was Created on 11/22/2022 @ 11:44:17 AM

ADMINISTRATIVE

32 A10 BANQUET CHAIR
2 A12 WRITING LEDGE
2 A13 POS COUNTER
2 A14 TRASH CABINET
2 A16 POS CABINET
2 A17 CABINET WITH DRAWER AND SHELF
2 A18 CABINET WITH ADJUSTABLE SHELVES
1 A19 CABINET WITH SLIDE OUT SHELF
1 A1E SAFE W/ ELECTRONIC LOCK
1 A20L CABINET WITH DRAWER AND LEFT HINGE DOOR
1 A20R CABINET WITH DRAWER AND RIGHT HINGE DOOR
1 A5C-4 4' CORK BULLETIN BOARD (OPEN)
9 A5C-6 6' CORK BULLETIN BOARD (OPEN)
2 A5EC-4 4' CORK BULLETIN BOARD (ENCLOSED)
1 A6 KEY CABINET SYSTEM
2 AUAS ENTERPRISE SELF-CHECKOUT ATTENDANT STATION
2 E38AS POS EQUIPMENT FOR SCO ATTENDANT STATION
8 E38SS SCANNER/SCALE (NO DISPLAY)
13 E38TP THERMAL PRINTER (FOR CHECKSTANDS)
12 E38TS TOUCHSCREEN POS (FOR OEM MOUNT)
2 GE107 BIOMETRIC READER FOR T&A
1 GE121 WESTERN UNION TERMINAL (VENDOR SUPPLY)
13 GE14 OFFICE CHAIR
14 GE156 EFT PIN PAD & CREDIT CARD READER
2 GE15C CONFRENCE ROOM TABLE
6 GE36-2 FILE CABINET (2-DRAWER VERTICAL)
1 GE36-4 FILE CABINET (4-DRAWER VERTICAL)
6 GE36-5 FILE CABINET (5-DRAWER LATERAL)
1 GE36 FILE CABINET (2-DRAWER LATERAL)
1 GE38S TOUCHSCREEN POS WITH STAND
15 GE38 POS TERMINAL WITH CASH DRAWER
1 GE41SC 8' SCAN COORDINATOR WORKSTATION
2 GE67 MONEY ORDER MACHINE (VENDOR SUPPLY)
1 GE68 CALCULATOR
1 GE7-3672 MANAGERS DESK
11 GE7 DESK

APPAREL

1 ALE59 VOLUME TABLE WITH 2 END FRAMES

ARCHIVE

2 A15 2 DRAWER FILE CABINET
8 ALS9665-FS ENTERPRISE STD.'BOUNTIFUL'(96' FM-65' RM)(DEACTIVATED)
6 ALU4C USCAN GENESIS W/ 4 BAG CAROUSEL ON LEFT
6 ARU4C USCAN GENESIS W/ 4 BAG CAROUSEL ON RIGHT
1 B55SS SELF SERVICE BREAD SLICER (DEACTIVATED)
1 D132B NU-VU MOBILE HOLDING CABINET (DEACTIVATED)
2 D14CS-208 SINGLE COMBI CHICKEN OVEN & STAND 208V
1 D14S-208 SINGLE COMBI OVEN W/ STAND 208V
1 D40B HIGH VOLUME PRESSURE FRYER (W/ CONTROLS)(DEACTIVATED)
1 DHFS06SS 6' SERVICE HOT FOOD CASE (DEACTIVATED)
1 E102B THINCLIENT & MONITOR FOR QUEVISION
2 E27 PRICE CHECKER (MOUNT @ 48" AFF) (DEACTIVATED)
1 E28P DELI ORDER KIOSK PRINTER FOR PREP AREA
1 E7B BACK-UP PRINTER (FOR OFFICE AREA) (DEACTIVATED)
3 E9K EAS KEYPAD (INFO. PANEL)
2 E9L EAS PEDESTALS (6' TO 9' OPENING)
1 E9S EAS PEDESTALS W/ CONTROLLER (3' TO 6' OPENING)
1 F51 FTD RACK
1 F55V POTTING SOIL RACK (DEACTIVATED)
1 GE102 PC & MONITOR (DEACTIVATED)
1 GE172 TICKETMASTER TERMINAL (VENDOR SUPPLY)(DEACTIVATED)
1 GE18R AUTOMATIC BALER RIGHT-HAND HINGED (208V)
5 GE1S SCONCE FLY ZAPPER (AREAS IN CUSTOMER VIEW)
1 GE53 ELECTRIC SERVICE ENTRANCE
7 GM20G-60 KPNR GRAPHIC ENDCAP (60" H)
7 GM20N-60 NARROW OTC ENDCAP (60" H)
1 GM3V-3 3FT CIGARETTE FIXTURE (DEACTIVATED)
2 GM3V 4FT CIGARETTE FIXTURE (DEACTIVATED)
1 GM85BT BATTERY ENDCAP CHECKSTAND MERCHANDISER
4 GM85BV BEVERAGE ENDCAP CHECKSTAND MERCHANDISER
1 GM85KF KPF ENDCAP CHECKSTAND MERCHANDISER
8 GM85LG LARGE TAIL CHECKSTAND MERCHANDISER
2 GM85MG MAGAZINE ENDCAP CHECKSTAND MERCHANDISER
2 HD HAND DRYER
17 P53 3' X 3' ORCHARD BIN (UPSCALE) (DEACTIVATED)
16 P71B BULK PRODUCE TABLE (DEACTIVATED)
9 P71HB HALF SIZE BULK PRODUCE TABLE (DEACTIVATED)
9 P71LE PRODUCE TABLE LEFT END
9 P71RE PRODUCE TABLE RIGHT END
1 PA AUTOMATIC PAPER TOWEL DISPENSER (DEACTIVATED)
1 PL1SLND SEAFOOD PREP SINK (NO DISPOSER/LHDB)
1 R11P EXT. WALL MOUNTED PIN PAD ENCLOSURE FOR RX DRIVE THRU
1 R30SW NARCOTICS WALL SAFE
1 R40V HEALTH STATION (VENDOR SUPPLIED) (DEACTIVATED)
4 R85 WAITING AREA CHAIR
5 R86 WAITING AREA CHAIR WITHOUT ARMS
1 RPP PIN PAD FOR RX DRIVE THRU/WALK-UP
1 ST1-480S 24V CHARGER (480V-1PH-260 AMPS PER HOUR)
1 TMP-432 KITCHEN VIGNETTE HOUSE (DEACTIVATED)
2 TMP-435 KITCHEN MISSION TABLE (SMALL) (DEACTIVATED)
6 TMP-436 KITCHEN MISSION TABLE (MEDIUM) (DEACTIVATED)
6 TMP-437 KITCHEN MISSION TABLE (LARGE) (DEACTIVATED)
4 TMP-439 KITCHEN ISLAND TABLE (NO TOPPER) (DEACTIVATED)
2 TMP-446 KITCHEN MISSION TABLE HUTCH (DEACTIVATED)
1 BMDLIXSC7SS 7' MDLP SELF CONT SS DESSERT ISLAND (DECTIVATED)
6 BV5D12HX 12' FIVE-DECK BEVERAGE CASE
4 BV5D8HX 8' FIVE-DECK BEVERAGE CASE
1 BV5DLCMEHX FIVE-DECK BEVERAGE LEFT CONTOURED MIRRORED END
2 BV5DLSMEHX FIVE-DECK BEVERAGE LEFT SLAB MIRRORED END
3 BV5DRSMEHX FIVE-DECK BEVERAGE RIGHT SLAB MIRRORED END
1 D1D6B-2 6' SINGLE DECK CHEESE CASE (V2)
1 D1D90B-2A 90 DEGREE OUTSIDE SINGLE DECK CHEESE WEDGE (V2A)
1 D1DLEB-2 SINGLE DECK CHEESE LEFT PANEL END (V2)
1 D1DREB-2 SINGLE DECK CHEESE RIGHT PANEL END (V2)
4 D203SC3 3 DOOR DELI STORAGE REFRIG (SELF-CONT.) (DEACTIVATED)
4 D204SC3 3 DOOR DELI STORAGE FREEZER (SELF-CONT.) (DEACTIVATED)
4 D5D12HX 12' FIVE-DECK DELI CASE
3 D5D8HX 8' FIVE-DECK DELI CASE
1 D5DLCMEHX FIVE-DECK DELI CASE LEFT CONTOURED MIRRORED END
2 D5DLSMEHX FIVE-DECK DELI CASE LEFT SLAB MIRRORED END
1 D5DRCMEHX FIVE-DECK DELI CASE RIGHT CONTOURED MIRRORED END
2 D5DRSMEHX FIVE-DECK DELI CASE RIGHT SLAB MIRRORED END
7 DA5D12HX 12' FIVE-DECK DAIRY CASE
2 DA5D8HX 8' FIVE-DECK DAIRY CASE
2 DA5DLSMEHX FIVE-DECK DAIRY LEFT SLAB MIRRORED END
1 DA5DNSC304B 4' 5-DECK NARROW SELF CONT. DAIRY CASE (DEACTIVATED)
1 DA5DRCMEHX FIVE-DECK DAIRY RIGHT CONTOURED MIRRORED END
1 DA5DRSMEHX FIVE-DECK DAIRY RIGHT SLAB MIRRORED END
1 DMDL12HX 12' MDLP DELI CASE (48" H.)
1 DMDL8HX 8' MDLP DELI CASE (48" H.)
1 DMDLLEHX MDLP CASE LEFT END (48" H.)
1 DMDLREHX MDLP CASE RIGHT END (48" H.)
2 F5DN8HX 8' 5-DECK NARROW FLORAL CASE
1 F5DNLGEHX 5-DECK NARROW FLORAL CASE LEFT GLASS END
1 F5DNRGEHX 5-DECK NARROW FLORAL CASE RIGHT GLASS END
1 G27BSC 2 DOOR REFRIG. PET FOOD MERCH SELF CONT. (DEACTIVATED)
1 G27DSCF 2 DOOR SELF CONT FROZEN PET FOOD MERCH (DEACTIVATED)
10 G85BSC CHECKSTAND REFRIGERATED MERCHANDISER (DEACTIVATED)
1 GE136VHP 6 COMPRESSOR VERTICAL IPAC
2 GE216B UPRIGHT REFRIGERATOR/FREEZER (DEACTIVATED)
4 M5D12HX 12' FIVE-DECK DELI MEAT CASE
2 M5DFR12HX 12' FIVE-DECK FRESH MEAT CASE
3 M5DFR8HX 8' FIVE-DECK FRESH MEAT CASE
1 M5DFRLCMEHX FIVE-DECK FRESH MEAT CASE LEFT CONTOURED MIRRORED END
1 M5DFRLSMEHX FIVE-DECK FRESH MEAT CASE LEFT SLAB MIRRORED END
1 M5DFRRCMEHX FIVE-DECK FRESH MEAT CASE RIGHT CONTOURED MIRRORED END
1 M5DFRRSMEHX FIVE-DECK FRESH MEAT CASE RIGHT SLAB MIRRORED END
2 M5DLCMEHX FIVE-DECK DELI MEAT CASE LEFT CONTOURED MIRRORED END
1 M5DLSMEHX FIVE-DECK DELI MEAT CASE LEFT SLAB MIRRORED END
1 M5DRCMEHX FIVE-DECK DELI MEAT CASE RIGHT COUNTOURED MIRRORED END
2 M5DRSMEHX FIVE-DECK DELI MEAT CASE RIGHT SLAB MIRRORED END
2 MS8HE 8' SERVICE MEAT CASE
1 MSLEHE SERVICE MEAT CASE LEFT PANEL END
1 MSREHE SERVICE MEAT CASE RIGHT PANEL END
3 P5D12HX 12' FIVE-DECK PRODUCE CASE
1 P5D8HX 8' FIVE-DECK PRODUCE CASE
5 P5DGR12HX 12' FIVE-DECK PRODUCE CASE (GREENRACK)
1 P5DLCMEHX FIVE-DECK PRODUCE LEFT CONTOURED MIRRORED END
2 P5DLSMEHX FIVE-DECK PRODUCE LEFT SLAB MIRRORED END
2 P5DRCMEHX FIVE-DECK PRODUCE RIGHT CONTOURED MIRRORED END
1 P5DRSMEHX FIVE-DECK PRODUCE RIGHT SLAB MIRRORED END
1 R37B UNDERCOUNTER REFRIGERATOR (BIOMEDICAL) (DEACTIVATED)
1 R42B REFRIGERATOR/FREEZER (BIOMEDICAL) (DEACTIVATED)
1 S5DFR6HX 6' FIVE-DECK FRESH SEAFOOD CASE
1 S5DFRLSMEHX FIVE-DECK FRESH SEAFOOD LEFT SLAB MIRRORED END
1 S5DFRRSMEHX FIVE-DECK FRESH SEAFOOD RIGHT SLAB MIRRORED END

BAKERY

1 B100 AIR BRUSH W/COMPRESSOR
1 B103H-4-I_LM 4 BIN BOLILLO BREAD DISPLAY (LIMBER MAPLE)
1 B107C-I_LM SMALL BREAD DESTINATION DOUBLE SIDED (CENTER UNIT)
(LIMBER MAPLE)
2 B107E-I_LM BREAD DESTINATION (END UNIT) (LIMBER MAPLE)
2 B109G GAS DOUBLE RACK OVEN
4 B109R-12 RACK FOR DOUBLE OVEN (12 PAN)
10 B109R-15 RACK FOR DOUBLE OVEN (15 PAN)
4 B109R-20 RACK FOR DOUBLE OVEN (20 PAN)
1 B124B-60 DOUBLE DOOR (60" DEEP) PROOFER (4-5 SINGLE RACKS)
1 B153-I_LM IN LINE ARTISAN BREAD DISPLAY (LIMBER MAPLE)
1 B154-I_LM IN LINE BAGUETTE BREAD DISPLAY (LIMBER MAPLE)
2 B155-I_LM IN LINE DONUT DISPLAY (LIMBER MAPLE)
2 B157-I_LM IN LINE UNIVERSAL SIDE PANEL (LIMBER MAPLE)
1 B224 MOBILE CAKE KIT CART
1 B225-I_LM BAKERY NESTING TABLES (SET OF 3) (LIMBER MAPLE)
4 B225F-I_LM BAKERY NESTING TABLES (LARGE SET OF 5) (LIMBER MAPLE)
1 B230 BAKERY TRASH CART
1 B234 PRIMETIME DONUT RACK
2 B44T SERVICE SCALE/UPC PRINTER (TOLEDO)
1 B99CDB CAKE IMAGING MACHINE
1 BCPT10CS 10' CAKE DECORATING PREP TABLE
1 BGDNIC12HI 12' NARROW GLASS DOOR ICE CREAM TEMP BAKERY (5 DOORS)
1 BGDNLEHI NARROW GLASS DOOR BAKERY LEFT END PANEL
1 BGDNREHI NARROW GLASS DOOR BAKERY RIGHT END PANEL
3 BMDL5HP 5' MDLP BAKERY CASE
1 BMDLLEHP MDLP BAKERY CASE LEFT END
1 BMDLREHP MDLP BAKERY CASE RIGHT END

BEVERAGE

1 BV6DW8B 8' UPSCALE CONDITIONED WINE CASE (REMOTE)
1 BV6DWLEB UPSCALE CONDITIONED WINE CASE LEFT END PANEL
1 BV6DWREB UPSCALE CONDITIONED WINE CASE RIGHT END PANEL

CHEESE

1 CHMOH MURRAY'S HYBRID OLIVE BAR INLINE

CONSTRUCTION

2 GE187 SET OF DOCK SEALS
3 GE188 GALVANIZED METAL HOOD W/18" PROJECTION
3 GE189 SET OF WHEEL CHOCKS
3 GE190 RAPID FORM PIT
3 GE20 MECHANICAL DOCK LEVELER
3 GE244 DOCK LIGHT (15W LED)
29 GE52 SUB FEEDER ELECTRIC PANEL (CONTRACTOR SUPPLY)
1 GE54A ANSUL SYSTEM FOR EXHAUST HOOD
1 GE54C UTIILITY CABINET FOR EXHAUST HOOD
1 GE54E CONTROL BOX FOR EXHAUST HOOD
1 GE54G-20 20' X 5' HOOD (SEE HVAC PLAN FOR ORDERING INFO)
1 GE54G-8 8' X 5' HOOD (SEE HVAC PLAN FOR ORDERING INFO)
9 GE64-4 4" PROTECTIVE POST (BACKROOM) (CONTRACTOR SUPPLY)
3 GE64-6 6" PROTECTIVE POST (BACKROOM) (CONTRACTOR SUPPLY)
5 GE64D DOCK DOOR PROTECTOR
1 PL20 EYE WASH STATION (CONTRACTOR SUPPLY)
2 PL24-2 BI-LEVEL DRINKING FOUNTAIN (CONTRACTOR SUPPLY)
2 PLC-1B 1 BOWL COUNTERTOP SINK (CONTRACTOR SUPPLY)
2 PLC-2B 2 BOWL COUNTERTOP SINK (CONTRACTOR SUPPLY)
2 PLUR ADA URINAL (CONTRACTOR SUPPLY)

DAIRY

4 DAMDLI8HC-2 8' MDLP DAIRY ISLAND CASE (UNITIZED)
4 DAMDLIEHC-2 MDLP DAIRY ISLAND END CASE

DELI-CHEESE

1 D115M MINI CHEESE WRAPPER (TABLE TOP)
1 D181 CHEESE CUTTER
1 D182 CHEESE SHREDDER
1 D195-5 PICKUP SOLID BACK HOT HOLDING CABINET
5 D20S DELI BUDDY SLICER STAND WITH SCALE SHELF
13 D23T SERVICE SCALE/UPC PRINTER (TOLEDO)
2 D259B COMPLETE CHICKEN TENDERS BREADING CART
1 D25 AUTOMATIC SLICER
5 D26 MANUAL SLICER
1 D299CM-2 COLD MEALS MENU BOARD (2 PANEL)
2 D299TV-48 49" DIGITAL MONITOR FOR DELI MENU BOARD KIT
1 D304B MOBILE CHEESE CART
1 D304DD-2 8' DOUBLE SIDED SNACK DESTINATION DISPLAY
3 D321 DELI TRANSPORT CART
1 D322-6 6 SHELF DELI BACK STOCK CART
1 D332V PRIVATE SELECTION RACK
1 D35-20 CHICKEN RACK FRYER CART
1 D36 DELI PREP MICROWAVE
2 D41 CUSTOM MILLWORK COUNTER (CONTRACTOR SUPPLY)
1 D60DE OPEN DUAL RACK FRYER (208 VOLT) VERSION
5 D7-2430 24" X 30" TABLE
2 D7-48 48" ROUND TABLE (ADA)
2 D77B RICE COOKER
1 D7TR TRASH CAN WITHOUT TRAY TOP
2 DMCS4 4' DRY SHELVING END
1 TMP-392 RAD CHARGING STATION
1 D262SC13 13 PAN QUICK CHILLER WITH TOUCHSCREEN
1 DM2THF6AM 6' TWO TIER HOT CHICKEN CASE
1 DMHF4AM 4' MOBILE HOT FOOD
1 D1D11B-2 11' SINGLE DECK CHEESE CASE (V2)
2 D1DSC4HP 4'X4' (SELF-CONT) REFRIGERATED MOBILE MERCHANDISER
1 DCFMD6HC 6' SELF SERVICE IN LINE MULTI DECK COLD CASE
2 DCFMDEHC UNIVERSAL END PANEL FOR MDLP IN LINE SS COLD CASE
1 DMDLIX12HC 12' MDLP DELI ISL. CASE (UNITIZED) (58"H)
2 DMDLIXEHC MDLP DELI ISLAND END CASE (58"H)
1 DMDLN6B 6' MDLP DELI CASE (51"H)(NARROW)
1 DMDLNLEB MDLP LEFT END PANEL (NARROW)
1 DMDLNREB MDLP RIGHT END PANEL (NARROW)
1 DMDLR12HC 12' FRESH SLICED MULTI DECK CASE (REMOTE)
1 DMDLRLEHC LEFT END FOR FRESH SLICED MULTI DECK CASE
1 DMDLRREHC RIGHT END FOR FRESH SLICED MULTI DECK CASE
1 DPSSUST8B-2 8' SUSHI PREP/DISPLAY CASE W/ REF. REAR STORAGE
1 DPSSUSTLEB-2 SUSHI PREP/DISPLAY LEFT PANEL END
1 DPSSUSTREB-2 SUSHI PREP/DISPLAY RIGHT PANEL END
1 DS12HE 12' SERVICE DELI CASE
2 DS8HE 8' SERVICE DELI CASE
1 DSLEHE SERVICE DELI LEFT PANEL END
1 DSREHE SERVICE DELI RIGHT PANEL END

DOORS

3 DR102DK 8'-6"W X 9'H SECTIONAL OVERHEAD DOCK DOOR
4 DR36CL 36" LEFT HINGED COOLER DOOR (84"H)
3 DR36CR 36" RIGHT HINGED COOLER DOOR (84"H)
3 DR36CS STRIP DOOR FOR 36" COOLER DOOR
1 DR36DL 3'-0" LEFT HINGED DUTCH DOOR (DIRECT BUY)
2 DR36FS STRIP DOOR FOR 36" FREEZER DOOR (7'H)
9 DR36L 3'-0" LEFT HINGED DOOR (DIRECT BUY)
5 DR36R 3'-0" RIGHT HINGED DOOR (DIRECT BUY)
7 DR36SD 3' X 7' DOUBLE ACTION SINGLE PLASTIC DOOR
1 DR36SLLE (EXT)7' LEFT SINGLE SLIDER AUTO ENTRANCE DOOR UNIT
1 DR36SLRI (INT)7' RIGHT SINGLE SLIDER AUTO ENTRANCE DOOR UNIT
2 DR39SLLI (INT) 8' LEFT SINGLE SLIDER AUTO ENTRANCE DOOR UNIT
1 DR42R 3'-6" RIGHT HINGED DOOR (DIRECT BUY)
1 DR44L 3'-8" LEFT HINGED DOOR (DIRECT BUY)
4 DR44R 3'-8" RIGHT HINGED DOOR (DIRECT BUY)
1 DR48CL 48" LEFT HINGED COOLER DOOR (84"H)
1 DR48CR 48" RIGHT HINGED COOLER DOOR (84"H)
1 DR48CS STRIP DOOR FOR 48" COOLER DOOR
1 DR48FS STRIP DOOR FOR 48" FREEZER DOOR (7'H)
1 DR48SD 4' X 7' DOUBLE ACTION SINGLE PLASTIC DOOR
1 DR5X8IDD 5' X 8'H DOUBLE ACTION DOUBLE IMPACT DOOR (INSULATED)
3 DR60BPE (EXT) 12' BI-PARTING SLIDER AUTO ENTRANCE DOOR UNIT
2 DR60BPI (INT) 12' BI-PARTING SLIDER AUTO ENTRANCE DOOR UNIT
4 DR60CL 60" LEFT HINGED COOLER DOOR (96"H)
1 DR60CR 60" RIGHT HINGED COOLER DOOR (96"H)
4 DR60CS STRIP DOOR FOR 60" COOLER DOOR
1 DR60FS STRIP DOOR FOR 60" FREEZER DOOR (8'H)
2 DR66DSD 5'-6"W X 7'H SECTIONAL OVERHEAD D.S.D. DOOR
2 DR6X8DD 6' X 8' DOUBLE ACTION DOUBLE PLASTIC DOOR
1 DR6X8IDD 6' X 8'H DOUBLE ACTION DOUBLE IMPACT DOOR (INSULATED)
2 DR6X9DD 6' X 9'H DOUBLE ACTION DOUBLE PLASTIC DOOR
1 DR7X9DD 7' X 9'H DOUBLE ACTION DOUBLE PLASTIC DOOR
1 DRADADD 5' X 8' (ADA) DOUBLE ACTION DOUBLE PLASTIC DOOR
1 DRCMP COMPACTOR DOOR
174 DR24 2'-0" FRENCH DOOR (PER QUOTE)

DRUG-GM

1 GM17S-3 3 FT KPNR LIGHTED SHELVING SECTION (MADIX OR LOZIER)
16 GM17S-4 4 FT KPNR LIGHTED SHELVING SECTION (MADIX OR LOZIER)
1 GM22V BATTERY ENDCAP (VENDOR SUPPLY)
2 GM23V PROPANE TANK CAGE (VENDOR SUPPLY)
9 GM25C SADDLEBAG RACK (SET OF 2)
1 GM33V CARD SPINNER RACK
1 GM7M-3S 3 FT KPNR/OTC LIGHT VALANCE (STARTER) (MADIX)
2 GM7M-4S 4 FT KPNR/OTC LIGHT VALANCE (STARTER) (MADIX)
22 GM7M-4 4 FT KPNR/OTC LIGHT VALANCE (MADIX)
1 GM8K KPF PREPAID WIRELESS KIOSK
1 GM8R MOBILE PHONE RECYCLING ATM
1 GM9-8 8FT GIFT CARD ENDCAP

ELECTRONICS

24 E102 THINCLIENT & MONITOR
2 E12C LASER PRINTER (GENERAL USE)
1 E15I-DSD IDF RACK/48 PORT PATCH PANEL KIT (DSD)
3 E15I-RX IDF RACK/48 PORT PATCH PANEL KIT (RX)
1 E18V KROGER ATM
1 E19BE EXTERIOR REDBOX DVD RENTAL KIOSK (VENDOR SUPPLY)
2 E22TV-47 LCD WIDESCREEN (47")
1 E42-17 19" LED COMPUTER MONITOR
2 E47 LABLE PRINTER
2 E6 MFP (FAX PRINTER COPIER SCANNER)
1 E7MFD COPY PRINT SCAN MFD
1 E8B BILL COUNTER
1 GE102-2 PC & MONITOR
1 GE102A ACCOUNTING CABINET PC MONITOR & THERMAL PRINTER

FLORAL

1 F41 CUSTOM MILLWORK COUNTER (CONTRACTOR SUPPLY)
4 F45-3 3 TIER OUTDOOR FLORAL DISPLAY
3 F45-4 3 TIER 1/2 ROUND GRID TOP FLORAL ROUNDER DISPLAY
4 F46 NESTING TABLE SET
4 F50D-8 8' BALLOON DISPLAY FIXTURE
1 F50DWE-4_CM 4' BALLOON WALL DISPLAY FIXTURE (COCOA MAPLE)
1 F50 BALLOON SPINNER RACK (VENDOR SUPPLY)
3 F6W WOOD CRATES (SET OF 3)
2 F9 HELIUM TANK (VENDOR SUPPLY)

GENERAL

1 FM FULL LENGTH MIRROR (CONTRACTOR SUPPLY)
5 GE11C DEPARTMENT HEAD COMPUTER WORKSTATION
1 GE155 COIN COUNTER (VENDOR SUPPLY)
4 GE183 SANITIZER AND HOSE CABINET
1 GE186 MICROWAVE
1 GE198 4FT WOOD SLAT BENCH
1 GE199 NON-MOTORIZED WHEELCHAIR W/BASKET
1 GE1 FLY ZAPPER (DOCK/ BACKROOM HALLWAY)
3 GE205BHC RECYCLE BIN HOUSING UNIT (CENTER)
2 GE205BHL RECYCLE BIN HOUSING UNIT (LEFT)
2 GE205BHR RECYCLE BIN HOUSING UNIT (RIGHT)
7 GE205BL LARGE RECYCLE BIN (VENDOR SUPPLY)
4 GE205RCP CANS AND PLASTIC RECYCLE MACHINE (REAR LOAD)
2 GE205RG GLASS RECYCLE MACHINE (REAR LOAD)
2 GE205TC TRASH COMPACTOR FOR RECYCLING
1 GE209H SPECIAL NEEDS GROCERY CART
1 GE215L-480 AUTOMATIC BALER LEFT-HAND HINGED (480V)
1 GE230-35-480 35 CUBIC YARD MOBILE COMPACTOR & RECEIVER (480 VOLT)
2 GE235-2C 2 LEVER SPRAY DOWN PROPORTIONER (VENDOR SUPPLY)
4 GE235-2 2 LEVER SPRAY DOWN PROPORTIONER (VENDOR SUPPLY)
6 GE235-3 3 LEVER SPRAY DOWN PROPORTIONER (VENDOR SUPPLY)
7 GE236-2C 2 BUTTON PROPORTIONER FOR 3-COMP SINK (VENDOR SUPPLY)
1 GE236S SMALL 1 BUTTON PROPORTIONER (VENDOR SUPPLY)
1 GE242 CLEANING CART
2 GE245 CART SANI-WIPE DISPENSER (KROGER SUPPLY)
2 GE246 BAG RECYCLE BIN (KROGER SUPPLY)
5 GE251-18 18" MOP & BROOM HOLDER (PREP AREAS)
21 GE252U URBAN BASCART
2 GE2C INSTANT LOTTERY TICKET VENDING MACHINE
1 GE2 LOTTERY TERMINAL (SERVICE) (VENDOR SUPPLY)
1 GE301 RESTROOM CLEANER
1 GE302 COOLER CASE CLEANER
1 GE41 CUSTOM MILLWORK COUNTER (CONTRACTOR SUPPLY)
4 GE44A BABY CHANGING STATION
1 GE4S SMART SAFE TR-400
24 GE63C-24 PROTECTIVE CHROME CORNER GUARD
18 GE63 REMOVABLE PROTECTIVE POST (SALES AREA)
1 GE81B DSD FLOOR DESK
2 GE84 STORAGE CABINET
1 GE87F 6FT INDOOR BENCH
46 GE88B LOCKER (3 TIER/LOUVERED DOORS)
3 GE94MS MONEY SERVICES QUEUING BAND POST
7 GE96B ELECTRONIC SHOPPING CART (REAR DRIVE)
1 GEDMV DMV KIOSK
7 H COAT HOOK (BY PARTITION SUPPLIER)
6 NR SANITARY NAPKIN DISPOSAL RECEPTACLE
16 PM MECHANICAL PAPER TOWEL DISPENSER (KROGER SUPPLY)
19 SD SOAP DISPENSER (KROGER SUPPLY)
8 TP TOILET PAPER DISPENSER (KROGER SUPPLY)
4 TR TRASH RECEPTACLE

GROCERY

4 G1-9648 SALES AREA 96" PALLET RACK SECTION (48"D X 72"H)
1 G109M-48 TORTILLA END CAP
9 G2-1846 DUMP BIN 3 TIER BLACK (18" DIA 45" H)
6 G2-3638V 36" X 36" FRITO-LAY DUMP BIN (VENDOR SUPPLIED)
6 G50-3 3' UNIVERSAL END DISPLAY (24"D)
50 G50-4 4' UNIVERSAL END DISPLAY (24"D)
6 G50-5 5' UNIVERSAL END DISPLAY (24"D)
15 G6W WOOD CRATE
1 G85-20 QUEUING MERCHANDISER RACK FOR 20' LENGTH
1 G96-C4 COMMERCIAL BAKERY 4 WAY UPRIGHT DISPLAY
1 G111SCV FROZEN FOOD SPOT MERCHANDISER (VENDOR SUPPLY)
2 G80SC-60 60 CU. FT. INDOOR ICE MERCHANDISER (S.C.)
1 G85BSC-2 CHECKSTAND REFRIGERATED MERCHANDISER
4 GGDIEHI GLASS DOOR ISLAND GROCERY END PANEL
1 GGDITT10HI 10' GLASS DOOR ISLAND TWIN TEMP GROCERY (4 DOORS)
3 GGDITT12HI 12' GLASS DOOR ISLAND TWIN TEMP GROCERY (5 DOORS)
2 GGDITT6HI 6' GLASS DOOR ISLAND TWIN TEMP GROCERY (2 DOORS)
1 GGDITT8HI 8' GLASS DOOR ISLAND TWIN TEMP GROCERY (3 DOORS)
5 GGDNIC12HI 12' NARROW GLASS DOOR ICE CREAM TEMP GROCERY (5 DOORS)
1 GGDNIC6HI 6' NARROW GLASS DOOR ICE CREAM TEMP GROCERY (2 DOORS)
6 GGDNIC6PHI 6' NARROW GLASS DOOR GROCERY PROMO (2 DOOR)
5 GGDNLEHI NARROW GLASS DOOR GROCERY LEFT END PANEL
7 GGDNLT12HI 12' NARROW GLASS DOOR LOW TEMP GROCERY (5 DOORS)
1 GGDNLT6HI 6' NARROW GLASS DOOR LOW TEMP GROCERY (2 DOORS)
5 GGDNREHI NARROW GLASS DOOR GROCERY RIGHT END PANEL

MEAT

1 M10 MEAT SAW
1 M11T SERVICE SCALE/UPC PRINTER (TOLEDO)
15 M39B DOLLY FOR MEAT RPC
3 M42T TALL MEAT CART
5 M46B BACON RACK
9 M46 HALF ROUND WIRE BIN MERCHANDISER
1 M54-16 16' MEAT SERVICE CASE HUMIDITY CONTROL/TIMER
1 MAPPM AUTOMATED PRODUCTION PLANNING MONITOR KIT
1 MLR-BSALRBT MEAT BELT SEAL/AUTOLABEL SYSTEM W/ ROTARY BIN
1 MRAD RAD CHARGING STATION
1 MT208 MEAT TRASH CART
4 M1DSC4HP 4'X4' (SELF-CONT) REFRIGERATED MOBILE MERCHANDISER
1 M3DR4HC 4' MULTI DECK LOW PROFILE HOME CHEF CASE (REMOTE)
1 M3DRLEHC LEFT END FOR MULTI DECK LOW PROFILE HOME CHEF CASE
1 M3DRREHC RIGHT END FOR MULTI DECK LOW PROFILE HOME CHEF CASE
4 MWIDTG8HX 8' DUAL TEMP WIDE ISLAND MEAT W/GLASS
4 MWIDTGEHX DUAL TEMP WIDE ISLAND MEAT END CASE W/GLASS
2 MWIMTG8HX 8' MEDIUM TEMP WIDE ISLAND MEAT W/GLASS
2 MWIMTGEHX MEDIUM TEMP WIDE ISLAND MEAT END CASE W/GLASS

NATURAL FOODS

1 N6M PURE DRINKING WATER DISPENSING MECHANICAL (RO & TANK)
1 N6 PURE DRINKING WATER MACHINE W/JUG STAND (VEND. SUPPLY)

PHARMACY

6 R1-16IE 16' ISLAND SHELF END PANEL
30 R1-16I 16' ISLAND SHELF
18 R1-16WE 16' WALL SHELF END PANEL
27 R1-16W 16' WALL SHELF
2 R16 PHARMACY LASER PRINTER
1 R17 WALK-UP PHARMACY WINDOW
2 R27-3 3' PHARMACY WALL CABINET W/ DOORS
2 R27-4 4' PHARMACY WALL CABINET W/ DOORS
2 R29S OPEN CABINET W/ HEAVY DUTY SLIDE-OUT
10 R31 5 DRAWER CABINET
5 R32 BOTTLE DISPENSER CABINET
1 R33 SINK CABINET
1 R35 CABINET W/DOOR & (2) SHELVES
5 R36H 12" OPEN CABINET FOR TRASH OR RECORDS DESTRUCTION
1 R50B PRESCRIPTION VALIDATION & DISPENSING DEVICE
1 R50 COMPOUNDING SCALE
1 R53 PHARMACY DRIVE-UP COUNTERTOP
8 R54L 28" FINISHED PANEL END
10 R54S 24" FINISHED PANEL END
4 R56R RX RELEASE TO PATIENT MOUNTING POLE
4 R56WP RX WORKSTATION MOUNTING POLE (W/ PHONE MOUNT)
2 R56W RX WORKSTATION MOUNTING POLE
2 R57 RISER UNIT
1 R58TD REGISTER CABINET W/ DOOR (38"H)
3 R58T REGISTER CABINET (38"H)
3 R60 2 DWR FILE CABINET
2 R61 DROP-OFF/PICK-UP ADA KNEESPACE CABINET
1 R63S SMALL PRIVACY PANEL
2 R63 PRIVACY PANEL
1 R65L DROP-OFF COUNTER (LEFT HAND)
1 R65R DROP-OFF COUNTER (RIGHT HAND)
1 R67 PACKING BIN (12 PIGEON HOLES)
1 R68 COAT/PURSE CLOSET
6 R69B-3 3' MODULAR HANG BAG WILL CALL UNIT
1 R69E PET MEDS ENDCAP
1 R79T TABLE
2 R80 PHARMACY STOOL
4 RIS RX IMAGE SCANNER
11 RPC RX EASYFILL PRN PC & 17" LCD
6 RTP RX THERMAL PRINTER (BACKTAGS & VIAL LABELS)

PICKUP

1 C56M1 MOD 1 MARSHAL DESK POLE SYSTEM
1 C56M2 MOD 2 MARSHAL DESK POLE SYSTEM
1 C56M3 MOD 3 MARSHAL DESK POLE SYSTEM
1 CLE1 KROGER HANDHELD 24 UNIT CHARGING BASE STATION
1 CR-2 SINGLE RACK CHARGING STATION
12 E38PS PRODUCE STAND ALONE SCALE FOR PICKUP
1 ST21 PALLY CART
12 ST22E PICKER CART 3 TOTE EXTENSION
12 ST22 PICKER CART
7 ST23 TOTE STORAGE DOLLY
1 ST25 MOD 1 TILL DRAWER WITH PULLOUT PRINTER SHELF BELOW
1 ST26 MOD 2 LETTER FILE DRAWER WITH PULLOUT PRINTER SHELF
1 ST30B PICKUP U-BOAT (OVERSIZED) WITH BRAKE

PRODUCE

1 P31T SERVICE SCALE/UPC PRINTER (TOLEDO)
2 P32T PRODUCE TOP LOADING SCALE WITH 4 QUART BOWL
1 P54 PRODUCE MISTING CONTROL/TIMER
1 P69 PRODUCE MARKDOWN RACK
5 P72BN BANANA TABLE
2 P1DSC4HP 4'X4' (SELF-CONT) REFRIGERATED MOBILE MERCHANDISER
1 P1DSC55J_CM 5'X5' TWO TIER REFRIGERATED PROMO CASE (SELF-CONT) (COCOA MAPLE)
4 PMSC6M-3_SR 6' ULTRA FRESH BERRY CASE (SELF-CONT) 240 V. (SILVER RIFTWOOD)

SEAFOOD

1 S115E ENERGY EFFICIENT WRAPPER (TABLE TOP)
1 S24T SERVICE SCALE/UPC PRINTER (TOLEDO)
1 S203BR2 2 DOOR SEAFOOD STORAGE REFRIGERATOR (REMOTE)
1 S204BR2 2 DOOR SEAFOOD STORAGE FREEZER (REMOTE)
1 S36TR-12 REMOTE ICE FLAKER W/ CART TRANSPORT SYSTEM (1500 LB.)
1 SGDNLEHI NARROW GLASS DOOR SEAFOOD LEFT END PANEL
1 SGDNLT10HI 10' NARROW GLASS DOOR LOW TEMP SEAFOOD (4 DOORS)
1 SGDNREHI NARROW GLASS DOOR SEAFOOD RIGHT END PANEL
1 SS12HC-2 12' SERVICE SEAFOOD CASE
1 SSLEHC-2 SERVICE SEAFOOD CASE LEFT END PANEL
1 SSREHC-2 SERVICE SEAFOOD CASE RIGHT END PANEL
2 SWILTG8HX 8' LOW TEMP WIDE ISLAND SEAFOOD W/GLASS
2 SWILTGEHX LOW TEMP WIDE ISLAND SEAFOOD END CASE W/GLASS

SINKS

1 PL1BR COUNTERTOP SINK (ADA BREAKROOM)
1 PL1F FLORAL SINK (DROP-IN)
1 PL1M MOP SINK (CONTRACTOR SUPPLY)
2 PL1PC-18 1 COMPARTMENT PREP SINK (18" BOWL) (NO DRAINBOARD)
1 PL1PC 1 COMPARTMENT PREP SINK (24" BOWL) (NO DRAINBOARD)
1 PL1RX COUNTERTOP SINK (DROP-IN)
6 PL3-20 3 COMPARTMENT SINK (20" DB)
2 PL3C-18NS SMALL 3 COMPARTMENT SINK (18" DB) (NO SPRAYER)
6 PLHSWE WALL MOUNT HAND SINK WITH EYEWASH
7 PLHSW HAND SINK (WALL MOUNT)

STOCK HANDLING

2 GE212-4K POWER PALLET JACK (4500 LB)
1 GE31-4S 4' ERECTA SHELV. (24"D) (STARTER)
2 GE32-3S 3' ERECTA SHELV. (18"D) (STARTER)
5 GE32-3 3' ERECTA SHELV. (18"D)
20 GE32-4S 4' ERECTA SHELV. (18"D) (STARTER)
7 GE32-4 4' ERECTA SHELV. (18"D)
1 GE32L-3S 3' LOW PROFILE ERECTA SHELVING 18"D (STARTER)
24 GE6-3 3' OVERHEAD GALV. STORAGE SHELV. (18"D)
191 GE6-4 4' OVERHEAD GALV. STORAGE SHELVING (18" DEEP)
22 GE93-102 PALLET RACK (102" SECTION) W/ 1 END FRAME
6 GE93S PALLET RACK STARTER END FRAME
14 GE99-4 4' LOCK-SPAN STORAGE SHELVING (6 SHELVES)
2 ST1-208S 24V CHARGER (208V-1PH-260 AMPS PER HOUR)
2 ST14 RECLAIM CART
2 ST17 2 SHELF CART
3 ST18L CAO CART (LARGE)
49 ST6 U-BOAT AISLE STOCKING CART
2 ST7 'GO-BACK' CART
2 ST9 TILT TRUCK FOR TRASH HAULING

TABLE

3 T3D 3' ENCLOSED TABLE
1 T3S 3' OPEN TABLE W/UNDERSHELF
3 T4D 4' ENCLOSED TABLE
2 T4S 4' OPEN TABLE W/UNDERSHELF
1 T4X8SF 4'x8' OPEN TABLE W/UNDERSHELF (FLAT TOP)
2 T5PB 5' OPEN TABLE W/POLYTOP AND BOATRACK
1 T5SS 5' CAKE PREP TABLE W/ PULL OUT SHELF AND UNDERSHELF
3 T6D 6' ENCLOSED TABLE
1 T6SF 6' OPEN TABLE W/UNDERSHELF (FLAT TOP)
1 T6SN 6' OPEN TABLE W/UNDERSHELF
4 T6S 6' OPEN TABLE W/UNDERSHELF
5 T8D 8' ENCLOSED TABLE
1 T4FSC 4' TABLE W/ FROZEN BASE (SELF CONT.)
2 T6SC 6' TABLE W/ REF. BASE

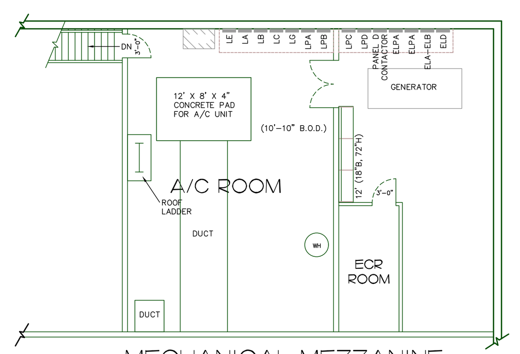

MECHANICAL MEZZANINE

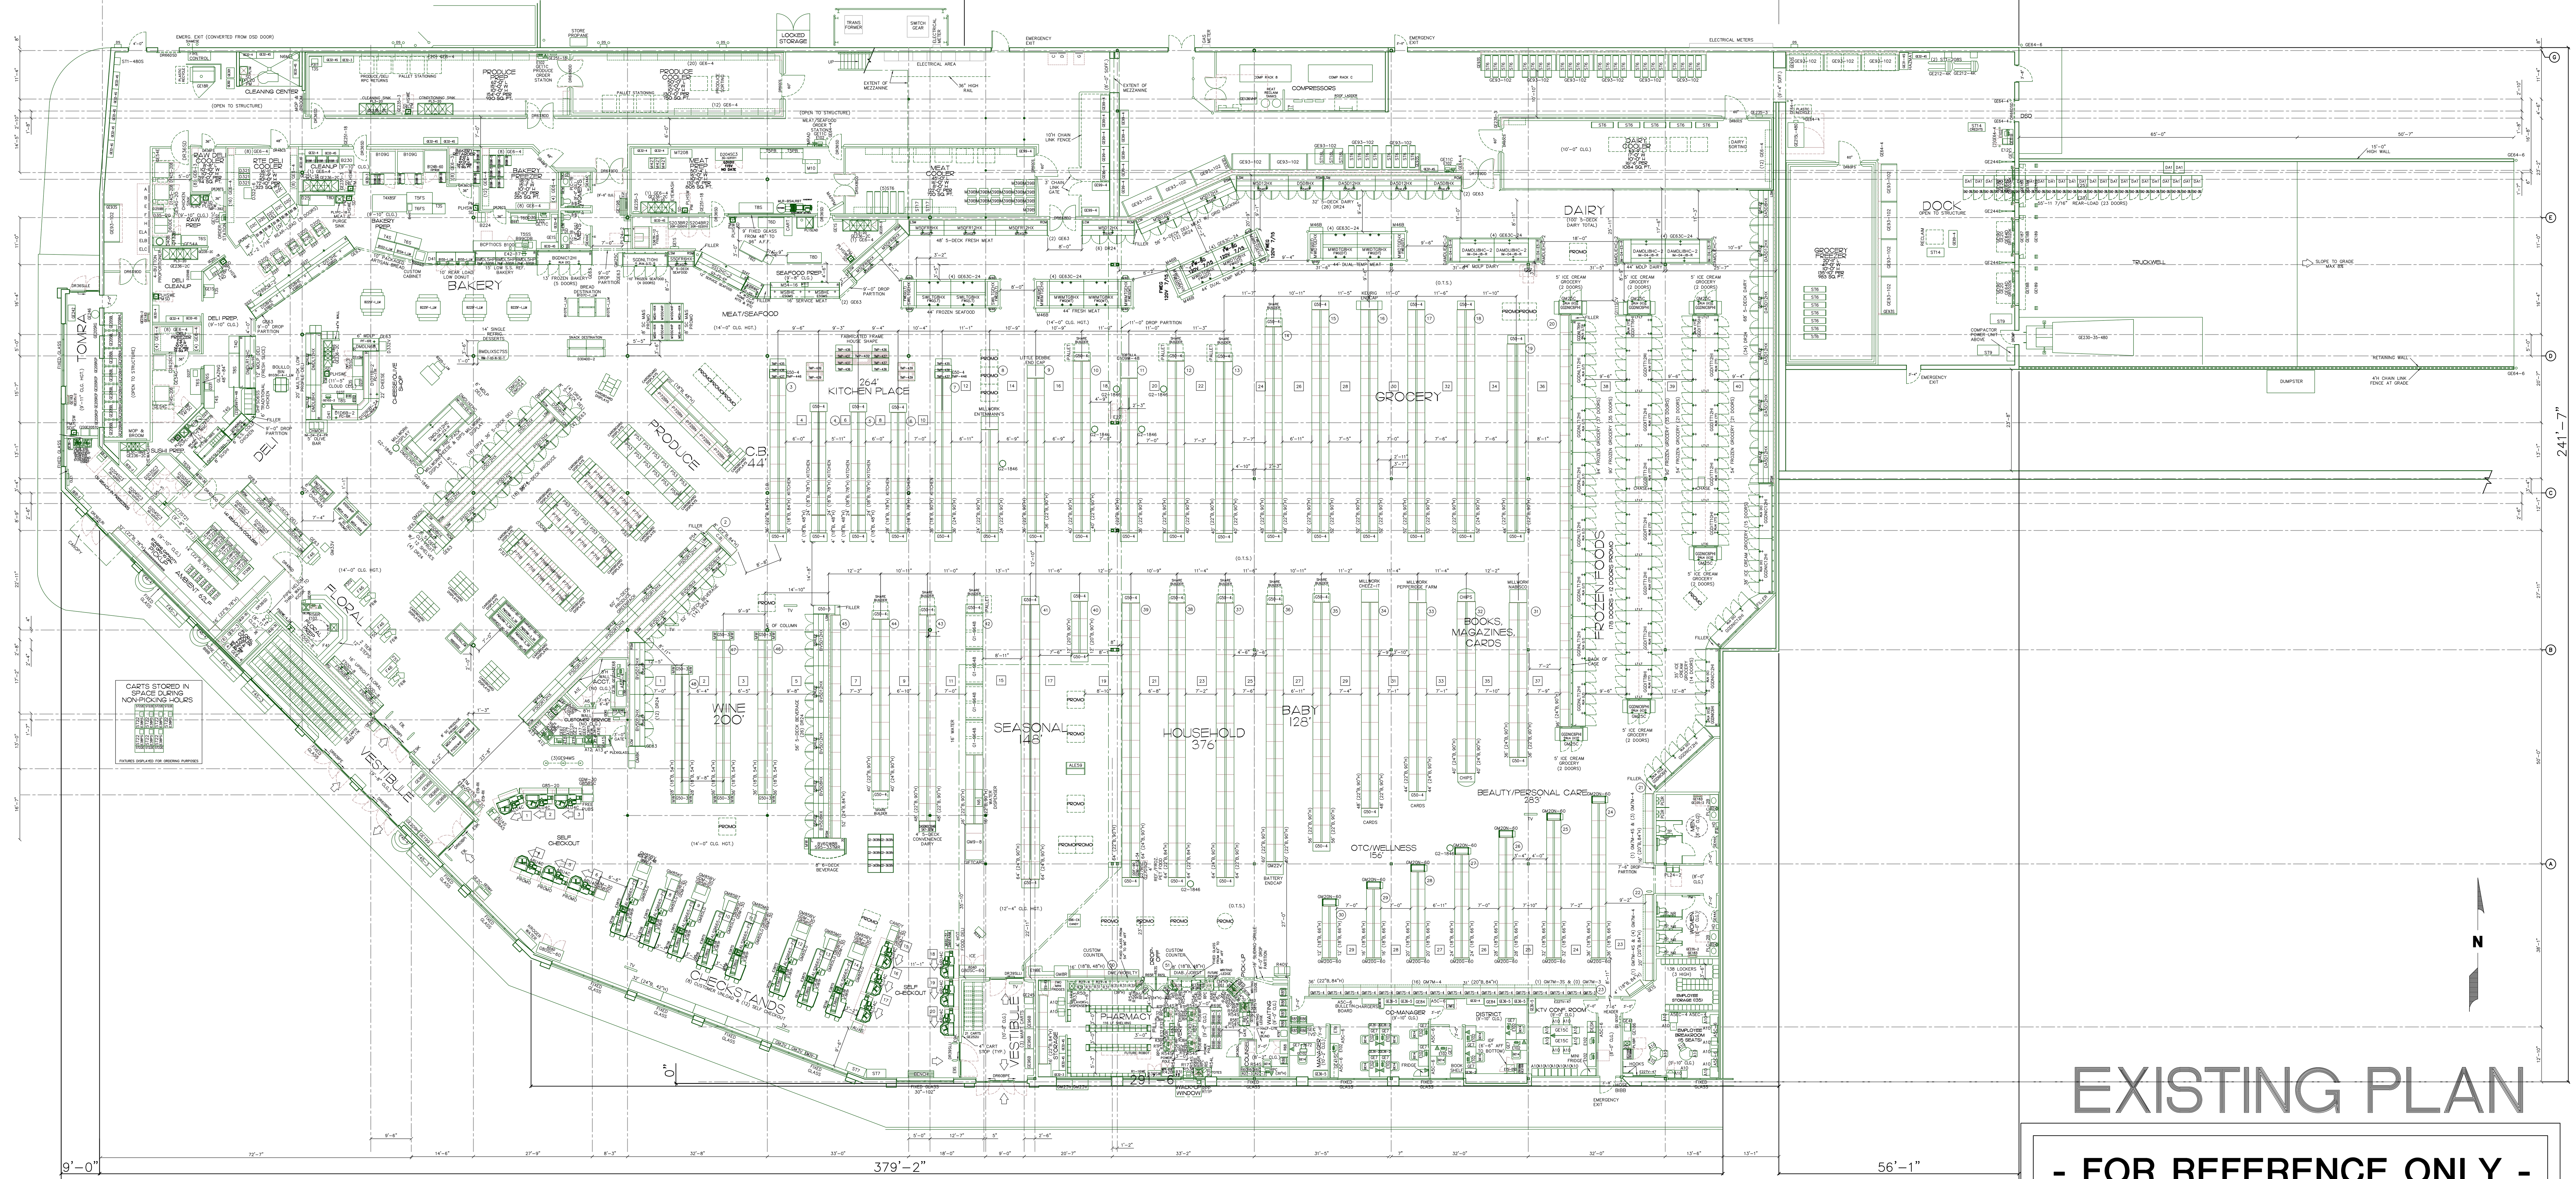

EXISTING PLAN

- FOR REFERENCE ONLY -

NOTE:
THIS DRAWING IS INTENDED ONLY TO SHOW THE REQUIREMENTS OF THE KROGER CO. THE DESIGN OF THE BUILDING TO CONFORM TO ALL APPLICABLE LAWS, CODES, REGULATIONS, ORDINANCES AND APPROVAL OF THE INSPECTION AUTHORITIES HAVING JURISDICTION IS THE RESPONSIBILITY OF THE ARCHITECT EMPLOYED BY THE OWNER.

MICHIGAN
(EXIST) BOUNTIFUL
40393 GRAND RIVER AVENUE
NOVI, MICHIGAN
PHONE: (248) 957-2254 FAX :(248) 957-2255

Kroger FRESH FOR EVERYONE™
GENERAL OFFICE
FACILITY ENGINEERING
1014 VINE ST, CINCINNATI, OHIO 45202
PH: (513) 762-4467 FAX: (513) 762-4012

EXISTING
D-409
12731 S SAGINAW ST
GRAND BLANC, MI 48439

CURRENT PLAN DATE: 11/22/2022
ORIGINAL PLAN DATE: 11/22/2022
DRAWN: C. KRESSER
CHECKED:
REVISIONS:
STANDARD PLOTTED SCALE: 1/16"=1'-0"

BUILDING STATS:	
TOTAL SHELVING	3,589 LF
SALES AREA % OF GROSS BUILDING	60,633 SF 67 %
BASE STORE	84,928 SF
MEZZANINE	1,951 SF
DOCK / UTILITY	4,097 SF

GROSS BUILDING 90,976 SF

AS-BUILT FIXTURE PLAN

STEEL PACKAGE ID: Not Applicable

D-409

SHEET: I1.0(XF1)

CAD FILE: