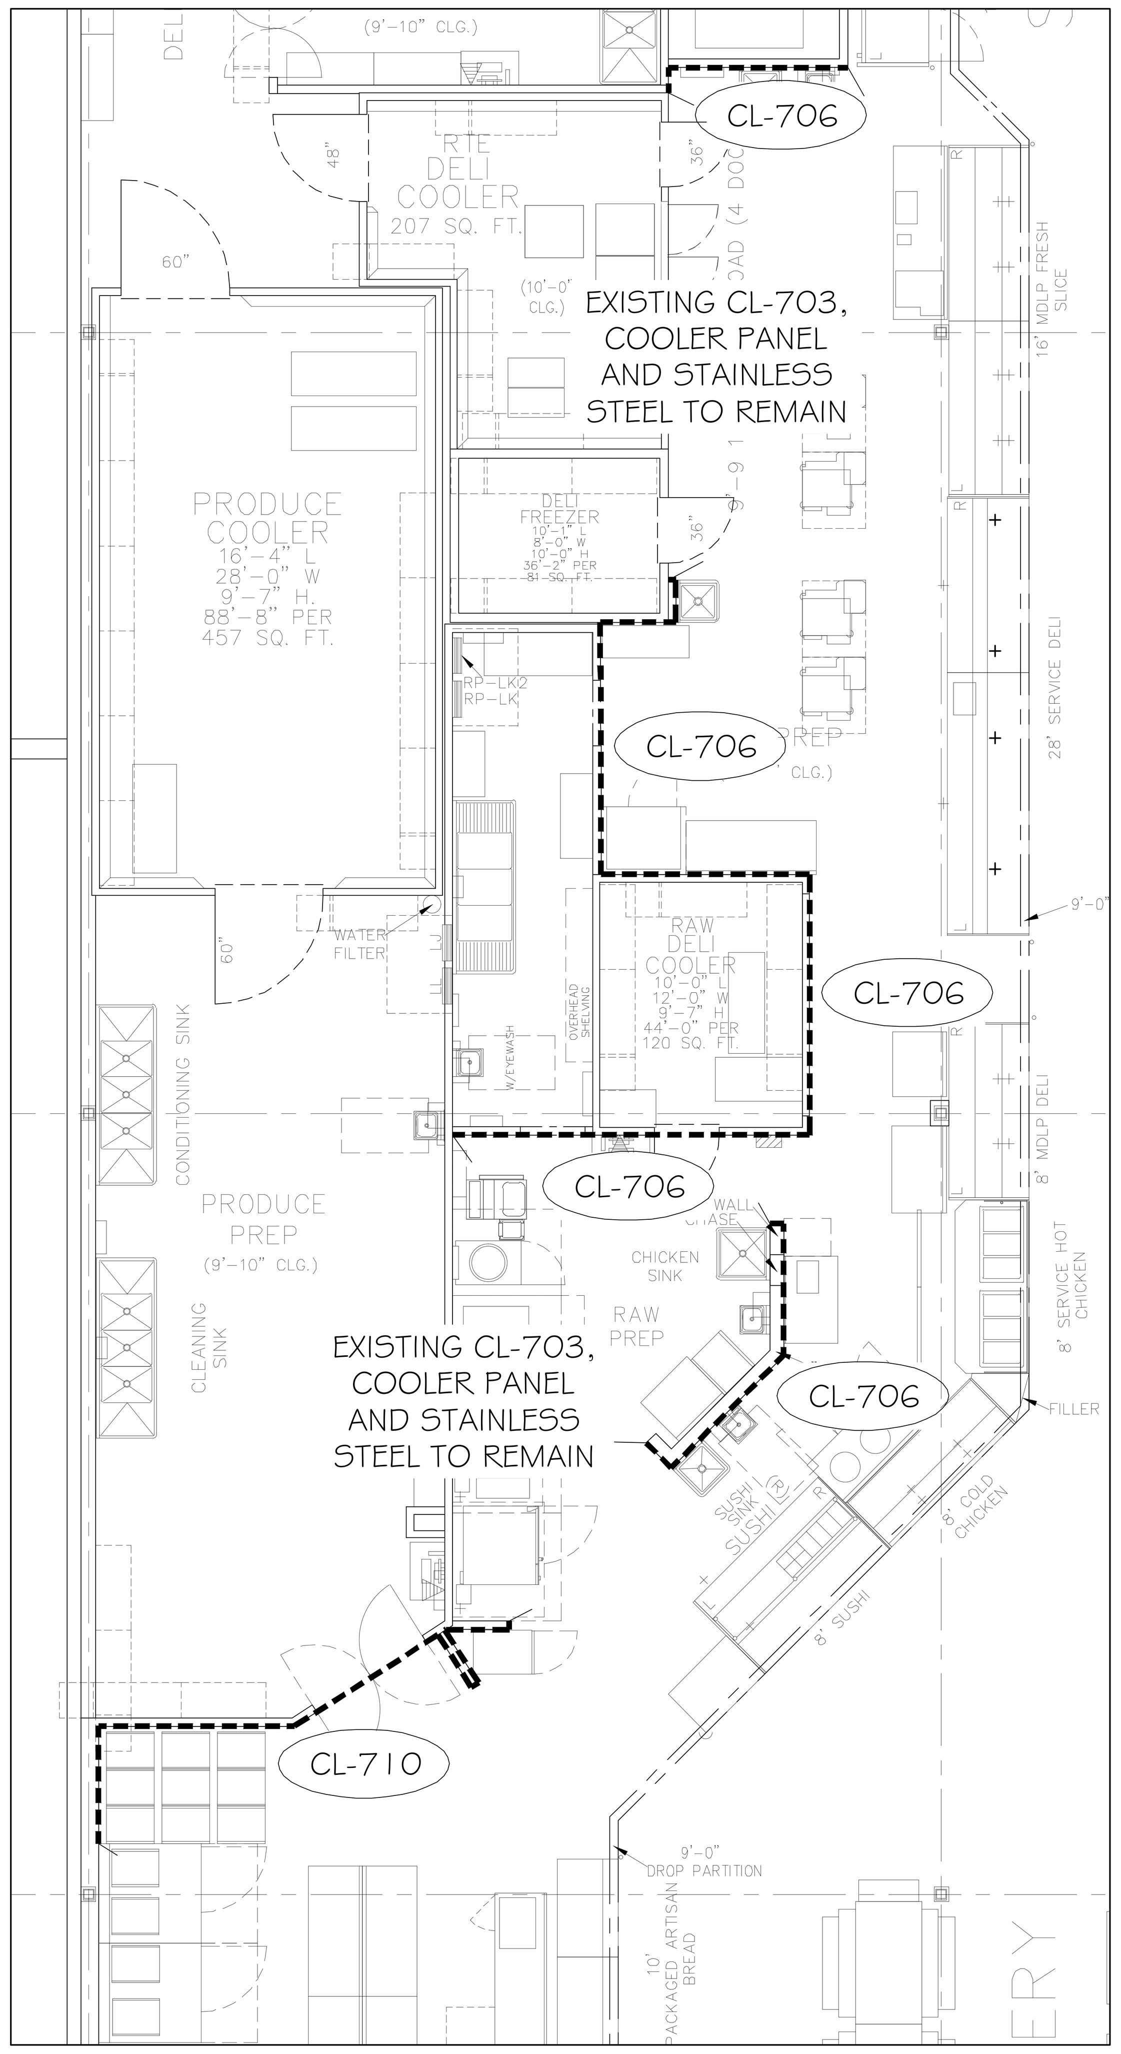

FFD & DELI PREP WALL FINISHES

SCALE: 3/16" = 1'-0"

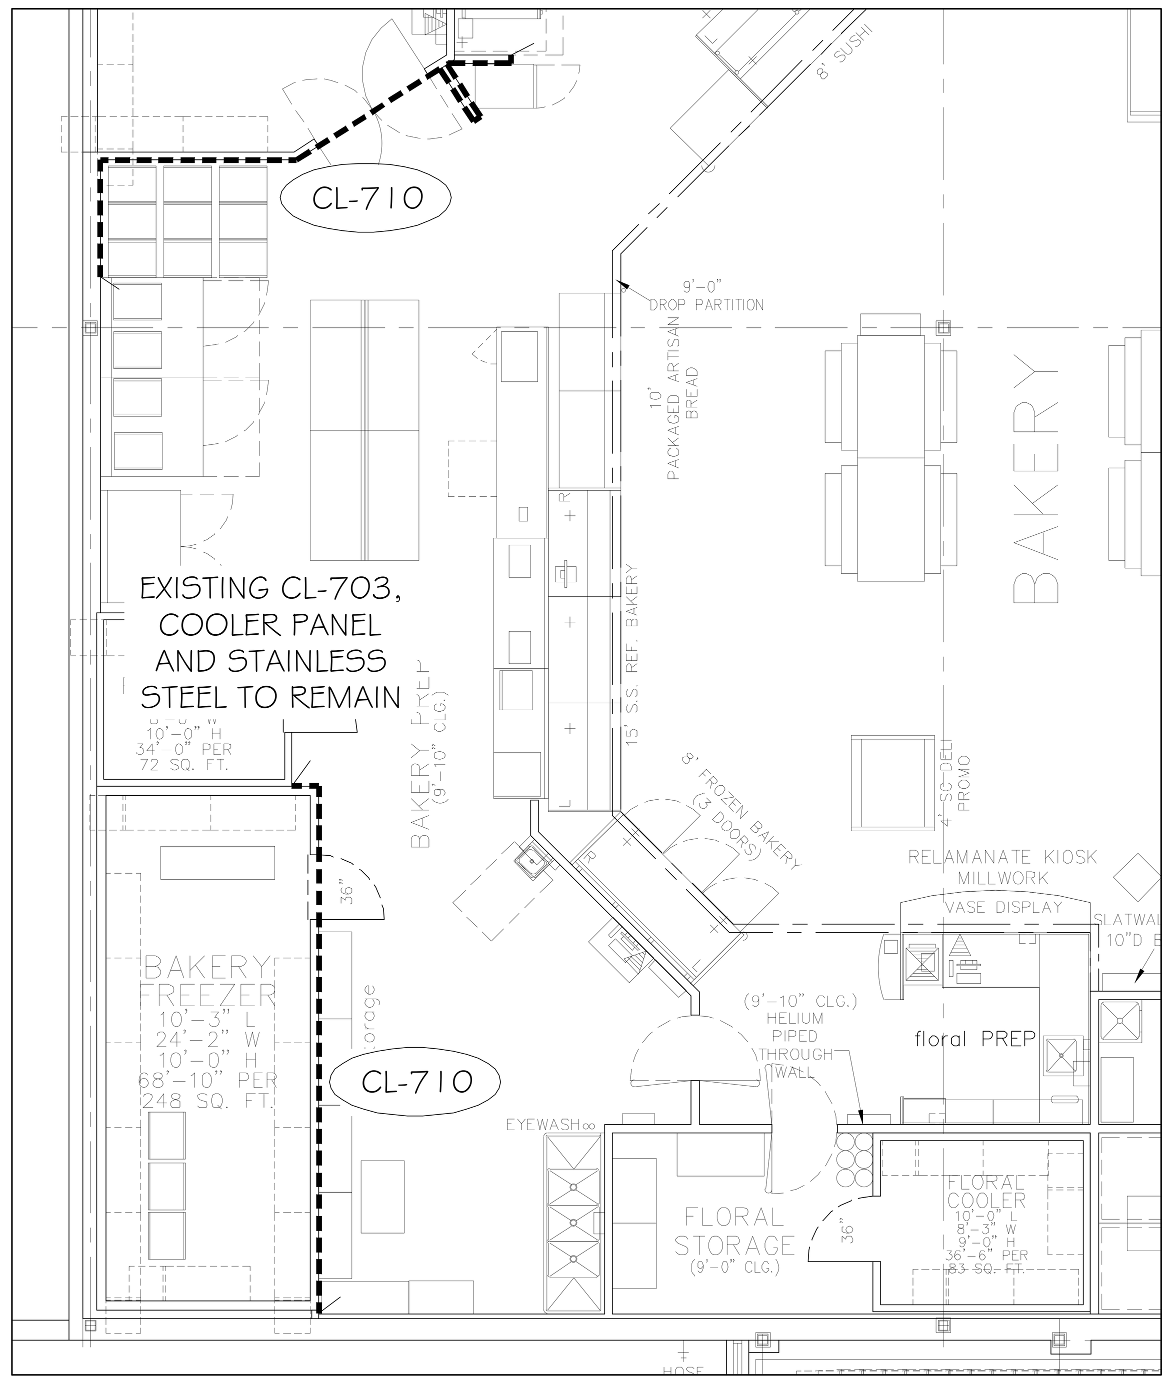

BAKERY PREP WALL FINISHES

SCALE: 3/16" = 1'-0"

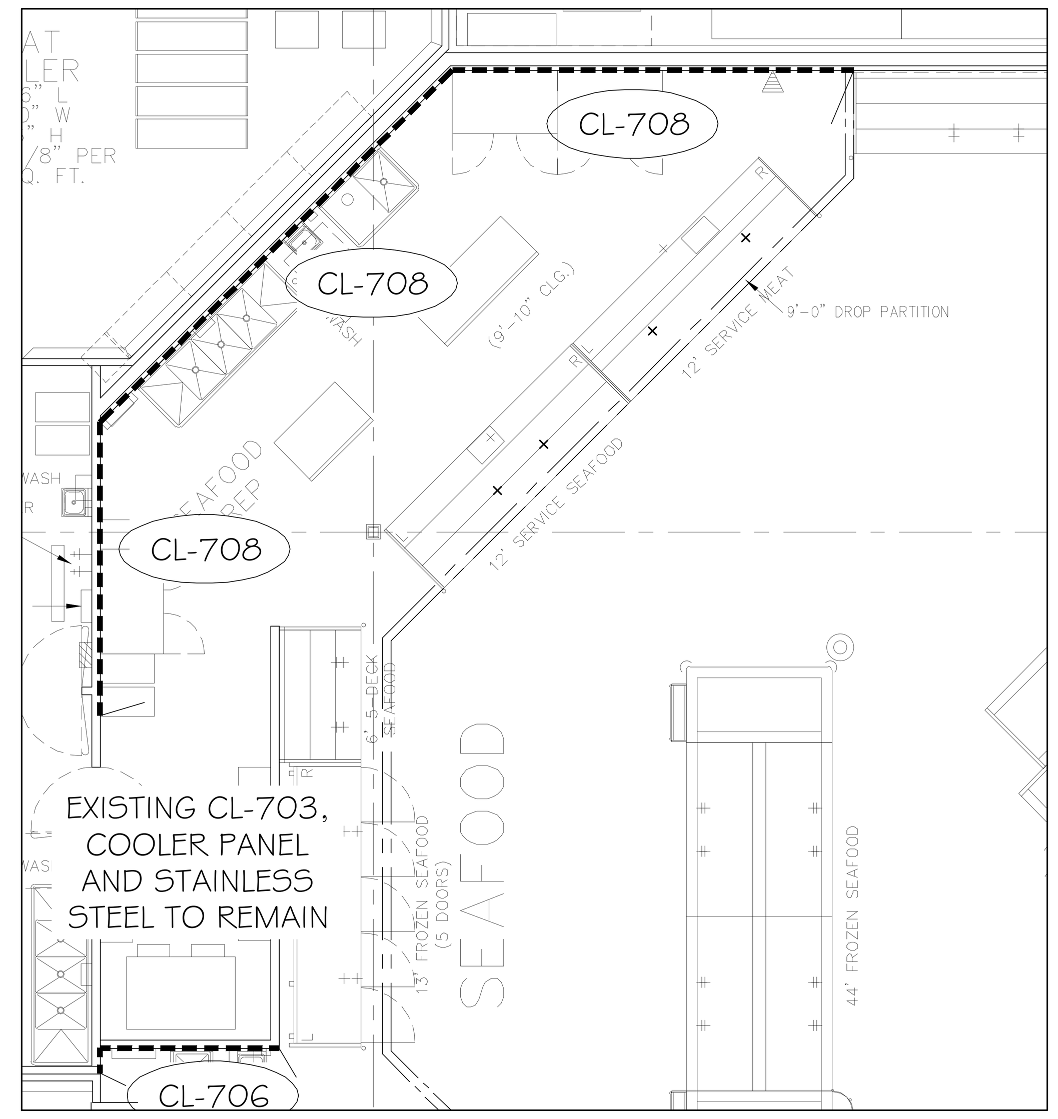

MEAT & SEAFOOD PREP WALL FINISHES

SCALE: 3/16" = 1'-0"

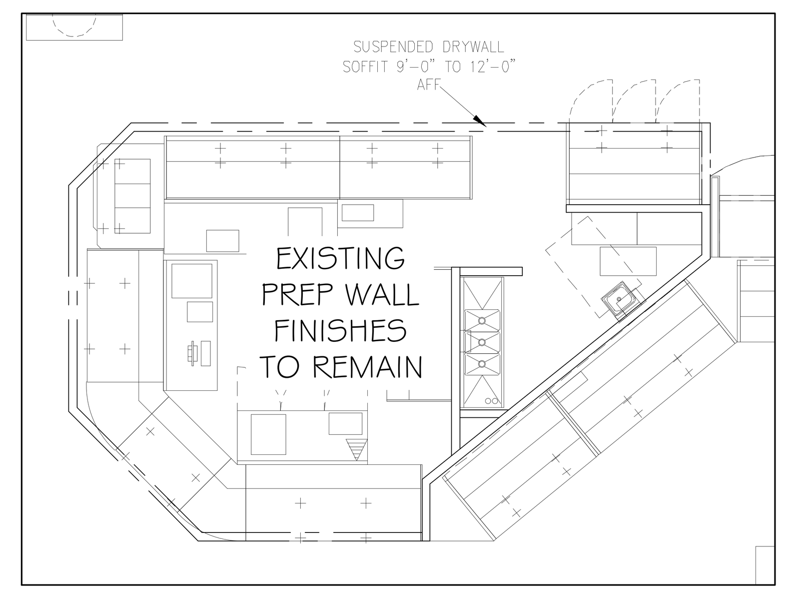

MURRAY'S PREP WALL FINISHES

SCALE: 3/16" = 1'-0"

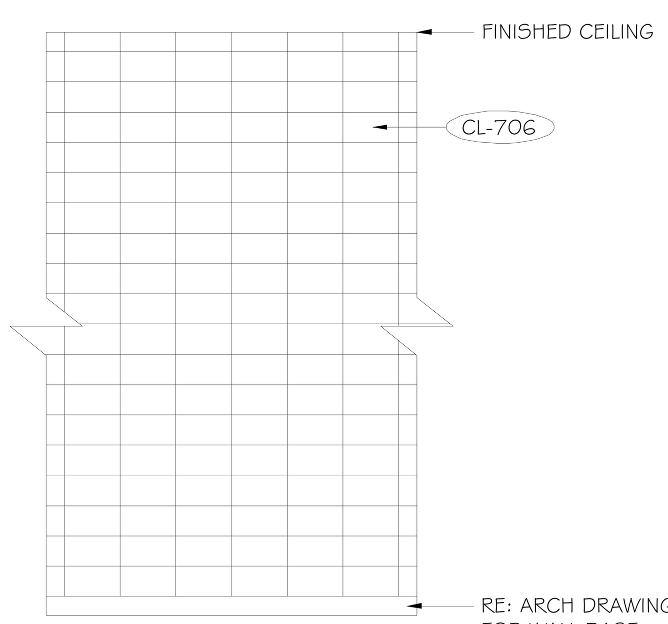

CL-706 ARTISAN FRP DETAIL AT DELI PREP DEPARTMENT
SCALE: 1/2"=1'-0"

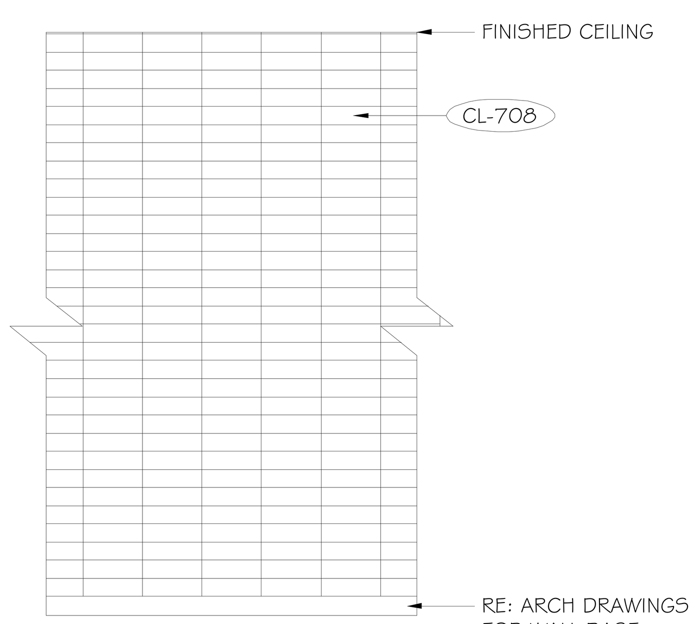

CL-708 ARTISAN FRP DETAIL AT MEAT&SEAFOOD DEPARTMENT
SCALE: 1/2"=1'-0"

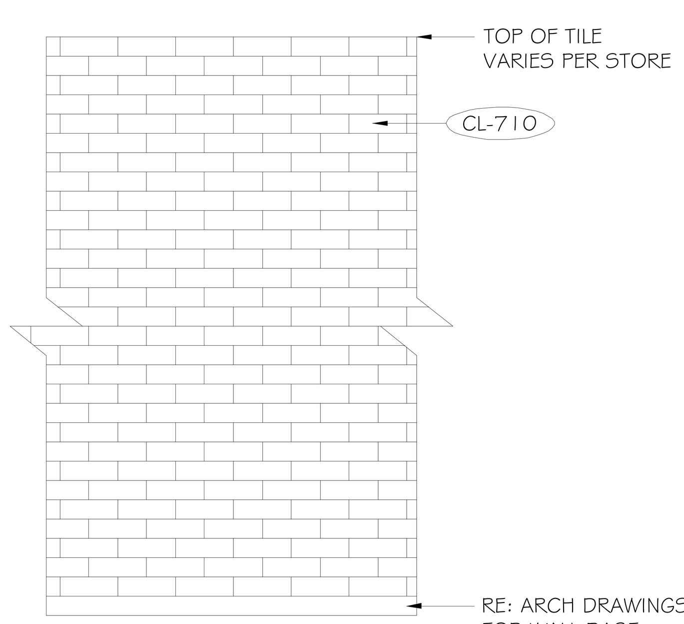

CL-710 FRP DETAIL AT MURRAY'S + BAKERY PREP DEPARTMENT
SCALE: 1/2"=1'-0"
**RE: KROGER SPECIFICATIONS FOR EDGE PROTECTION & GROUT

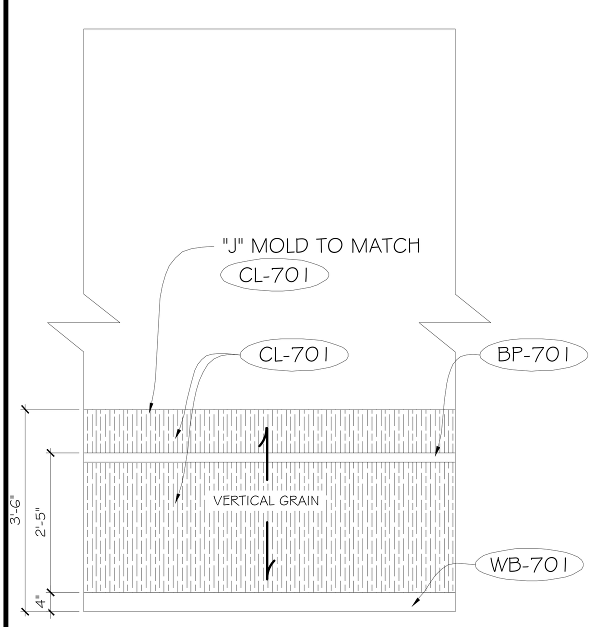

CD2 TYP. PHARMACY WAITING WALL WAINSCOT DETAIL
SCALE: 1/2"=1'-0"
**NOTE: CONTINUE WALLCOVERING 6" MIN BEYOND FIXTURES (TYP.)

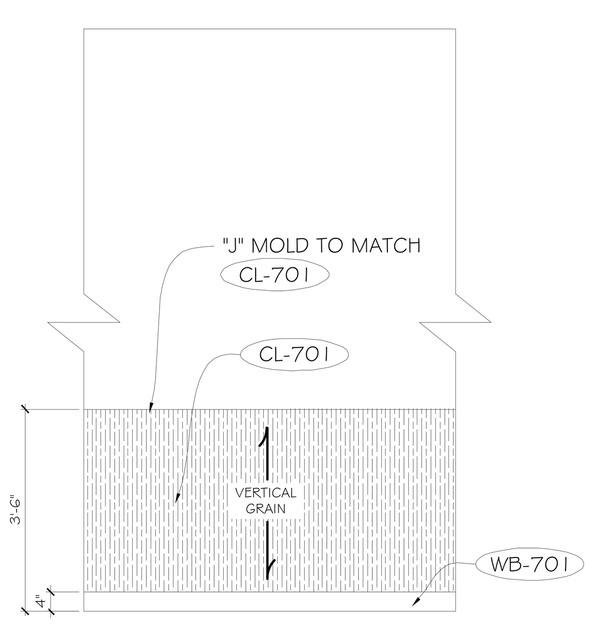

CD3 TYP. SEATING AREA WALL WAINSCOT DETAIL
SCALE: 1/2"=1'-0"
**NOTE: CONTINUE WALLCOVERING 6" MIN BEYOND FIXTURES (TYP.)

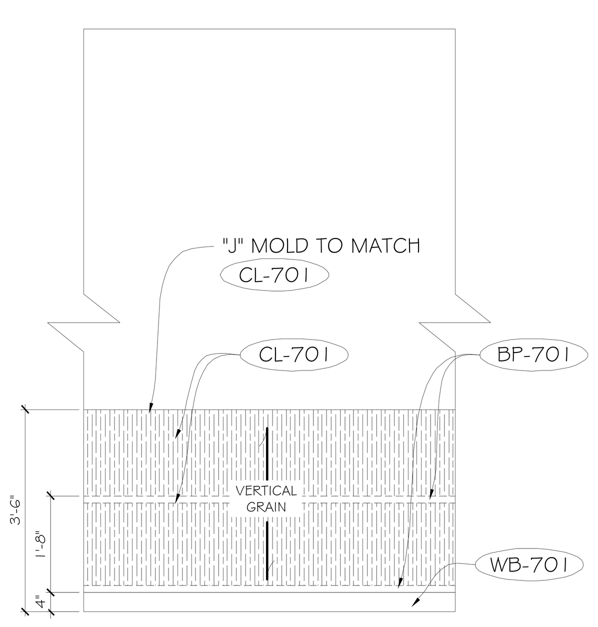

CD1 TYP. WALL WAINSCOT DETAIL
SCALE: 1/2"=1'-0"
**NOTE: CONTINUE WALLCOVERING 6" MIN BEYOND FIXTURES (TYP.)

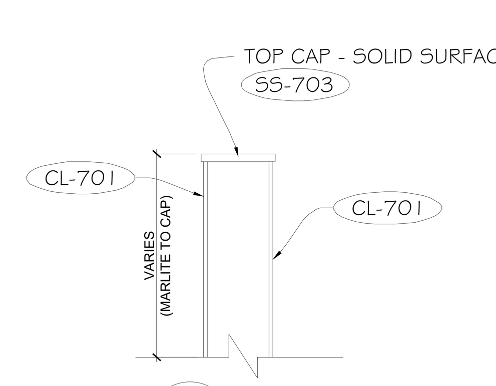

CD1.1 TYP. HALF HEIGHT WALL WAINSCOT DETAIL
SCALE: 1/2"=1'-0"
**NOTE: INCLUDES WALLS UP TO 54"H

WALL FINISH LEGEND

SYMBOL	DESCRIPTION
solid line	~~TILE CT-705, CT-706, CT-707 CT-708, CT-709, CT-714~~
dashed line	FRP CL-703, CL-706, CL-708 CL-709, CL-710
dash line	~~MURRAY'S CERAMIC TILE CT-701~~
dotted line	~~ELECTROSTATICALLY PAINTED PANELS~~
arrow line	GALVANIZED COOLER PANEL
tick line	~~STAINLESS STEEL~~
dash-dot line	STANDARD PAINT FINISHES

FINISH SCHEDULE (WALLS)

FOR REFERENCE ONLY. REFER TO ARCH. CD'S FOR SPECIFICATIONS.

SYMBOL	DESCRIPTION	NOTES	KROGER DIRECT BUY	FURNISHED BY G.C.
	BUMPER:			
BP-701	McCUE GREENGUARD 2 #105 "STEEL GRAY"	USE ON CL-701 ONLY WHEN NEEDED		•
~~WC-721~~	~~KOROSEAL INTERIOR PRODUCTS BLACK 01 / TEXTURE: DUNE PT~~	~~WAINSCOT FOR BACK OFFICE, HALLWAYS, BREAK ROOM ETC.~~		•
	CLADDING:			
CL-701	PAINTED BEADBORD PANELING WITH 2" SCORING PATTERN - SIZE: 16" x 96" x 1/4" SW 6991 "BLACK MAGIC" - MARLITE	WAINSCOT TO 3'-6" ATT		•
~~CL-703~~	~~FIBERGLASS REINFORCED PLASTIC PANELS (FRP) MARLITE - KEMLITE GLASBOARD - WHITE~~	~~PREP WALLS NOT VISIBLE TO CUSTOMERS~~		•
~~CL-704~~	~~SLOTTED FIBERBOARD WALL PANELS MARLITE - FORMICA 5887-58 MILENNIUM OAK~~	~~FOR USE IN FLORAL~~		•
~~CL-705~~	~~PRINTED FRP PANELING MARLITE - FP610 "HARD ROCK MAPLE"~~	~~NON-MURRAY'S CHEESE ISLAND WALL~~		•
CL-706	PRINTED FRP PANELING- 6" X 12" SCORING MARLITE - SYMMETRIX FRP - CL706, DARK GRAY	FOR USE IN DELI PREP AREAS		•
~~CL-707~~	~~PRINTED FRP PANELING- 12" X 24" SCORING MARLITE - SYMMETRIX FRP- CL707, LIGHT BLUE~~	~~FOR USE IN BAKERY PREP AREAS~~		•
CL-708	PRINTED FRP PANELING - 3" X 12" SCORING MARLITE - SYMMETRIX FRP- CL708, BLUE	FOR USE IN MEAT&SEAFOOD PREP AREAS		•
~~CL-709~~	~~PRINTED FRP PANELING- 6" X 12" SCORING MARLITE - SYMMETRIX FRP- CL709, WARM GRAY~~	~~FOR USE IN FFD PREP AREAS~~		•
CL-710	FRP PANELING- 4" X 12" SUBWAY MARLITE - SYMMETRIX FRP- SS917 G412R-1, WHITE/GREY	FOR USE IN MURRAY'S CHEESE & BAKERY		•
	~~**CERAMIC TILE:**~~			
~~CT-701~~	~~CERAMIC TILE 4" X 12", 5/16" THICK MOSA TILE (TEN THIRTY) 16900 WHITE~~	~~MURRAY'S CHEESE PREP WALLS RUNS HORIZONTALLY~~		•
~~CT-705~~	~~PORCELAIN TILE 12" X 24", MATTE FINISH ATLAS CONCORD, DWELL OFF WHITE~~	~~WINE/GROWLER BAR FRONT; HORIZONTAL GROUT: GT-707~~		•
~~CT-706~~	~~TILE 6" X 12", GLOSS FINISH, MOSA FIFTEEN THIRTY, DARK ANTHRACITE #2 30610~~	~~DELI PREP WALL HORIZONTAL GROUT: GT-701~~		•
~~CT-707~~	~~PORCELAIN TILE 12" X 24", GLOSS FINISH CROSSVILLE, SIMPATICO, LWT22 KINSHIP~~	~~BAKERY PREP WALL HORIZONTAL GROUT: GT-701~~		•
~~CT-708~~	~~PORCELAIN TILE 4" X 12", GLOSS FINISH PANTHEON, VIVA, 610-126~~	~~MEAT/SEAFOOD WALL HORIZONTAL GROUT: GT-704~~		•
~~CT-709~~	~~CERAMIC TILE 6" X 12", GLOSS FINISH MOSA TILE, MURALS, #30590 MID WARM GREY #4~~	~~PREPARED FOODS PREP WALL, HORIZONTAL GROUT: GT-708~~		•
~~CT-714~~	~~GLASS, METAL, STONE TILE 4" X 15" - DALTILE ENDEAVORS, FT62 ZEN STD, FT6258RANDS, WTCH~~	~~WINE/GROWLER BAR BACKSPLASH~~		•
~~CT-715~~	~~PORCELAIN TILE 4" X 12", GLOSS FINISH PANTHEON, VIVA, 610-101~~	~~MEAT/SEAFOOD WALL HORIZONTAL GROUT: GT-704~~		•
~~CT-716~~	~~TILE 6" X 12" - MOSA TILE GLOBAL, #16610 CREAM WHITE~~	~~BAKERY PREP WALL (LOW LRV); HORIZONTAL GROUT: GT-707~~		•
~~CT-717~~	~~TILE 4" X 12" - MOSA TILE GLOBAL, #16840 COOL WHITE~~	~~MEAT/SEAFOOD WALL (LOW LRV); HORIZONTAL GROUT: GT-704~~		•
CT-718	TILE 4" X 8" - MOSA TILE GLOBAL, #16900 ACCENT WHITE	DELI PREP WALL (LOW LRV); HORIZONTAL GROUT: GT-701		•
	~~**GROUT:**~~			
~~GT-701~~	~~TEC POWERGROUT #939 MIST~~	~~WALLS~~		•
~~GT-703~~	~~TEC POWERGROUT #927 LIGHT PEWTER~~	~~WALLS~~		•
~~GT-704~~	~~TEC POWERGROUT #929 CHARCOAL GRAY~~	~~WALLS~~		•
~~GT-707~~	~~TEC POWERGROUT #908 DOVE GRAY~~	~~WALLS~~		•
~~GT-708~~	~~TEC POWERGROUT #935 SILHOUETTE~~	~~WALLS~~		•
~~GT-709~~	~~TEC POWERGROUT #940 ANTIQUE WHITE BOTH~~	~~WALLS~~		•
	PAINT:			
PT-701	#SW 7723 - COLONY BUFF	REMODEL-PAINTED STRUCTURE		•
PT-702	#SW 7005 - PURE WHITE	DRYWALL CEILINGS		•
PT-703	#SW 7069 - IRON ORE	HOLLOW METAL DOORS & FRAMES		•
PT-704	#SW 7029 - AGREEABLE GRAY			•
PT-705	#SW 6464 - ALOE	MAIN VESTIBULE		•
PT-706	#SW 6203 - SPARE WHITE			•
PT-707	#SW 6991 - BLACK MAGIC			•
PT-708	#SW 7607 SANTORINI BLUE	COLOR MATCH TO MEAT & SEAFOOD PREP WALL		•
PT-709	#SW 7024 - FUNCTIONAL GRAY	COLOR MATCH TO FFD HOT MEALS PREP WALL		•
PT-710	#SW 7674 - PEPPERCORN	COLOR MATCH TO DELI PREP WALL; PEM DEPT (FM ONLY)		•
PT-711	#SW 9051 - AQUAVERDE	COLOR MATCH TO BAKERY PREP WALL; FROZEN DEPARTMENT		•
PT-714	#SW 9410 - BLUSTERY SKY	RESTROOM WALLS		•
~~PT-715~~	~~#SW 4090 - BLACK~~			•
~~PT-716~~	~~#SW 4084 - SAFETY YELLOW~~			•
PT-717	#SW 7012 - CREAMY			•
~~PT-718~~	~~#SW 6626 - SUNSET~~	~~SECONDARY VESTIBULE; HOUSEHOLD/ DOMESTICS (FM ONLY)~~		•
PT-719	#SW 6221 - MOODY BLUE	ACCENT WALL BEHIND BAR; HARDWARE DEPT (FM ONLY)		•
PT-720	#SW 6513 - TAKE FIVE	PHARMACY WALLS & WAITING AREA		•
PT-721	#SW 6709 - GLEEFUL	CAFE SEATING AREA; GARDEN DEPT (FM ONLY)		•
PT-722	#SW 6710 - MELANGE GREEN	CUSTOMER SERVICE DEPT		•
PT-723	#SW 6990 - CAVIAR	BISTRO/ FFD/ MTO AREA		•
~~PT-724~~	~~#SW 6921 - ELECTRIC LIME~~			•
~~PT-725~~	~~#SW 6715 - LIME GRANITA~~	~~VESTIBULE IN NEW STORES~~		•
~~PT-726~~	~~#SW 6253 - OLYMPUS WHITE~~	~~PEM DEPARTMENT~~		•
PT-727	#SW 6255 - MORNING FOG	PEM DEPARTMENT		•
PT-728	#SW 6726 - TALIPOT PALM	FLORAL DEPT		•
PT-729	#SW 7033 - BRAINSTORM BRONZE	STARBUCKS		
PT-730	#SW 7067 - CITYSCAPE	EXPOSED STEEL COLUMNS ON SALES FLOOR		
PT-750	#SW 4091 - SILVER BRITE	METAL PIPE RAILING AT OPEN MAZZANINE, REMODELS ONLY		•
~~DFAB~~	~~#SW 6683 - BEE~~	~~TOYS DECOR~~		•
~~DFAB~~	~~#SW 6855 - DRAGON FRUIT~~	~~TOYS DECOR~~		•
~~DFAB~~	~~#SW 9045 - BORA BORA SHORE~~	~~TOYS DECOR~~		•
~~PT-754~~	~~#SW 7048 - URBANE BRONZE~~	~~OHIO LIQUOR DECOR~~		•
~~PT-755~~	~~#SW 7046 - ANONYMOUS~~	~~OHIO LIQUOR DECOR~~		•
PT-756	#SW 7056 - USEFUL GRAY	OHIO LIQUOR DECOR		•
	WALL COVERING:			
WP-1	ZINSSER SHIELDZ - WALL COVERING PRIMER	REFER TO DECOR & FINISH ELEVATIONS		•

FINISH SCHEDULE (FLOORS)

FOR REFERENCE ONLY. REFER TO ARCH. CD'S FOR SPECIFICATIONS.

SYMBOL	DESCRIPTION	NOTES	KROGER DIRECT BUY	FURNISHED BY G.C.
	~~**CARPET:**~~			
~~CP-701~~	~~CARPET TILES BIGELOW/ MOHAWK GROUP-RENEGADE COLLECTION - THRILL SEEKER #358~~	~~PHARM. & CUST. SERV.~~		•
~~CP-702~~	~~CARPET TILES BIGELOW/ MOHAWK GROUP - LICHEN COLLECTION - SUBSTRATE #969~~	~~FITTING ROOMS~~		•
CP-703	CARPET TILES BIGELOW/ MOHAWK GROUP-TUFF STUFF QL312 STEP IN STYLE - OBSIDIAN #989	VESTIBULES QUARTER TURN		•
	~~**CERAMIC TILE:**~~			
~~CT-702~~	~~RECTIFIED PORCELAIN TILE - URBAN COLLECTION THREADS - 12"x24" - OLIVE MATTE - 3/8" THICKNESS~~	~~TOILET RM. FLOORS~~		•
~~CT-703~~	~~PORCELAIN TILE - URBAN COLLECTION LTD17 EDGE OF SEVENTEEN - 4" X 12" SATIN FINISH~~	~~TOILET RM. WALLS~~		•
CT-704	PORCELAIN TILE - URBAN COLLECTION LTD06 SIXTH SENSE - 4" X 12" GLOSS FINISH	TOILET RM. WALLS ACCENT		•
	~~**GROUT:**~~			
~~GT-702~~	~~TEC POWERGROUT #927 LIGHT PEWTER~~	~~FLOORS~~		•
~~GT-705~~	~~TEC POWERGROUT #945 LIGHT BUFF~~	~~FLOORS~~		•
GT-706	TEC POWERGROUT #929 CHARCOAL GRAY	FLOORS		•
	RESILIENT WALL BASE:			
RT-702	JOHNSONITE - TRANSITION #20 CHARCOAL			•
WB-701	JASONITE THERMOSET RUBBER WALL BASE #40 BLACK			•
	~~**LUXURY VINYL TILE:**~~			
~~VT-701~~	~~ARMSTRONG NATURAL CREATIONS DIAMOND 10 TECH. LVT 9"x48" - NA121 COASTAL CRAFTED BOARDWALK~~	~~PRODUCE, LIQUOR, KITCHEN PLACE & PERIMETER OF STORE~~		•
~~VT-702~~	~~ARMSTRONG NATURAL CREATIONS DIAMOND 10 TECH. LVT 12"x24" - NA332 BRACO PUTTY~~	~~GENERAL SALES REMODELS~~		•
VT-707	POLYFLOR NORTH AMERICA LVT - 6"x36" - 6504 WEATHERED COUNTRY PLANK	VESTIBULES		•

d|fab DESIGN FABRICATIONS
1100 EAST MANDOLINE AVE.
SUITE 100
MADISON HEIGHTS, MI 48071
T 800.968.9440
F 248.597.0989

COPYRIGHT © 2023

ALL DRAWINGS AND DESIGNS ARE THE SOLE PROPERTY OF DESIGN FABRICATIONS, INC. THESE DRAWINGS ARE NOT TO BE COPIED WITHOUT WRITTEN CONSENT FROM DESIGN FABRICATIONS, INC. THESE DRAWINGS WERE PREPARED EXCLUSIVELY FOR THIS PROJECT. IT IS ILLEGAL FOR UNAUTHORIZED PERSONS TO USE THESE DRAWINGS OR DESIGNS FOR ANY OTHER PROJECT.

DO NOT SCALE DRAWINGS- USE FIGURED DIMENSIONS ONLY.

SHEET TITLE
ENLARGED FINISH PLANS (ALTERNATE)

PROJECT NAME
KROGER, D-707

PROJECT LOCATION
2010 WHITTAKER RD.
YPSILANTI, MI

ISSUED FOR	DATE
80% REVIEW	02.02.24
100% DECOR	02.26.24

NO.	REVISED BY:	DATE
⚠	XXX	XXX

DRAWN: SK
CHECKED: CW/SD
SCALE: 3/16"=1'-0"
JOB NO.: 2306-045
SHEET #: I1.5b